

CONFIDENTIAL *Inc*

STATE CORPORATION COMMISSION OF KANSAS
OIL & GAS CONSERVATION DIVISION
WELL COMPLETION OR RECOMPLETION FORM
ACO-1 WELL HISTORY
DESCRIPTION OF WELL AND LEASE

API NO. 15-025-20978
County Clark
NW SW Sec. 3 Twp. 33 Rge. 21 East
..... West

Operator: License # 9657
Name QUINTANA PETROLEUM CORPORATION
Address 1050 - 17th Street
Suite 400
City/State/Zip Denver, Colorado 80265

1970 Ft North from Southeast Corner of Section
4610 Ft West from Southeast Corner of Section
(Note: Locate well in section plat below)

Purchaser N/A

Lease Name EDMONSTON Well # #5-3
Field Name Harper Ranch North

Operator Contact Person E. Scott Kimbrough
Phone (303)628-9211

Producing Formation N/A
Elevation: Ground 1918' 1931' KB


Contractor: License # 5380
Name EAGLE DRILLING, INC.

Wellsite Geologist Louis S. Bird
Phone (316)227-6041

Designate Type of Completion
 New Well Re-Entry Workover
 Oil SWD Temp Abd
 Gas Inj Delayed Comp.
 Dry Other (Core, Water Supply etc.)

if OWNED: old well info as follows:
Operator
Well Name
Comp. Date Old Total Depth

Section Plat

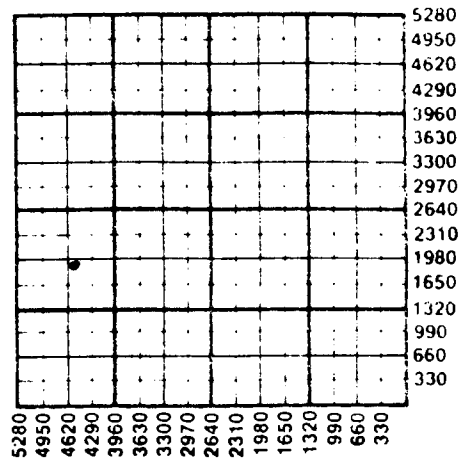

X

WATER SUPPLY INFORMATION

Disposition of Produced Water: Disposal
Docket # Repressuring

WELL HISTORY

Drilling Method:
 Mud Rotary Air Rotary Cable
3/16/87 3/24/87 P&A 3/26/87
Spud Date Date Reached TD Completion Date
5375' N/A
Total Depth PBTD

Amount of Surface Pipe Set and Cemented at 603 feet
Multiple Stage Cementing Collar Used? Yes No
If yes, show depth set
If alternate 2 completion, cement circulated from...feet depth to...w/...SX cmt
Cement Company Name
Invoice #

Questions on this portion of the ACO-1 call:
Water Resources Board (913) 296-3717
Source of Water: Purchased from City of Protection, KS
Division of Water Resources Permit #
Groundwater.....Ft North from Southeast Corner
(Well)Ft West from Southeast Corner of
Sec Twp Rge East West
Surface Water.....Ft North from Southeast Corner
(Stream, pond etc).....Ft West from Southeast Corner
Sec Twp Rge East West
Other (explain)
(purchased from city, R.W.D. #)

INSTRUCTIONS: This form shall be completed in triplicate and filed with the Kansas Corporation Commission, 200 Colorado Derby Building, Wichita, Kansas 67202, within 120 days of the spud date of any well. Rule 82-3-130, 82-3-107 and 82-3-106 apply.
Information on side two of this form will be held confidential for a period of 12 months if requested in writing and submitted with the form. See rule 82-3-107 for confidentiality in excess of 12 months.
One copy of all wireline logs and drillers time log shall be attached with this form. Submit CP-4 form with all plugged wells. Submit CP-111 form with all temporarily abandoned wells.