

STATE CORPORATION COMMISSION OF KANSAS
OIL & GAS CONSERVATION DIVISION

WELL COMPLETION OR RECOMPLETION FORM
ACO-1 WELL HISTORY

DESCRIPTION OF WELL AND LEASE

Operator: License # 9657
Name QUINTANA PETROLEUM CORPORATION
Address 1050 - 17th Street
Suite 400
City/State/Zip Denver, Colorado 80265

Purchaser N/A

Operator Contact Person E. Scott Kimbrough
Phone (303) 628-9211

Contractor: License # 5380
Name Eagle Drilling Co., Inc.

Wellsite Geologist Louis S. Bird
Phone (316) 227-6041

Designate Type of Completion

New Well Re-Entry Workover

Oil SWD Temp Abd
 Gas Inj Delayed Comp.
 Dry Other (Core, Water Supply etc.)

If OWWO: old well info as follows:

Operator
Well Name
Comp. Date Old Total Depth

WELL HISTORY

Drilling Method:

Mud Rotary Air Rotary Cable

1/2/87 1/10/87 P&A 1/12/87
Spud Date Date Reached TD Completion Date

5410' N/A
Total Depth PBTD

Amount of Surface Pipe Set and Cemented at 427 feet
Multiple Stage Cementing Collar Used? Yes No
If yes, show depth set feet
If alternate 2 completion, cement circulated from feet depth to w/ SX cmt

API NO. 15-025-20974

County Clark

SE SE NW Sec 11 Twp 33S Rge 21 East West

2970 Ft North from Southeast Corner of Section
2970 Ft West from Southeast Corner of Section

(Note: Locate well in section plat below)


Lease Name JOHNSON Well # #1-11

Field Name

Producing Formation N/A

Elevation: Ground 1873' KB 1886'

Section Plat

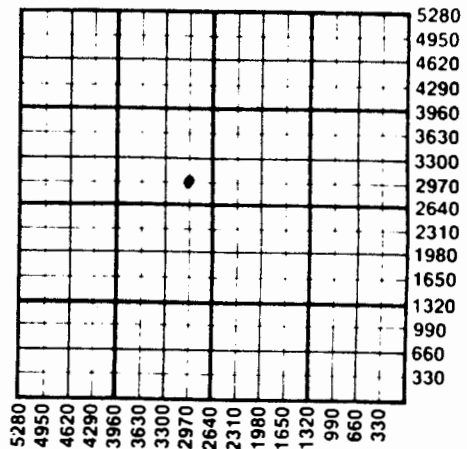

WATER SUPPLY INFORMATION

Disposition of Produced Water: Disposal Repressuring
Docket #

Questions on this portion of the ACO-1 call:

Water Resources Board (913) 296-3717

Source of Water:
Division of Water Resources Permit #

Groundwater Ft North from Southeast Corner (Well) Ft West from Southeast Corner of Sec Twp Rge East West

Surface Water Ft North from Southeast Corner (Stream, pond etc) Ft West from Southeast Corner Sec Twp Rge East West

Other (explain) Services - Ness City, Kansas (purchased from city, R.W.D. #)

INSTRUCTIONS: This form shall be completed in duplicate and filed with the Kansas Corporation Commission, 200 Colorado Derby Building, Wichita, Kansas 67202, within 90 days after completion or recompletion of any well. Rule 82-3-130 and 82-3-107 apply.

Information on side two of this form will be held confidential for a period of 12 months if requested in writing and submitted with the form. See rule 82-3-107 for confidentiality in excess of 12 months.

One copy of all wireline logs and drillers time log shall be attached with this form. Submit CP-4 form with all plugged wells. Submit CP-111 form with all temporarily abandoned wells.