

DX 78-1


Clark

KANSAS

Section 34 Township 33 Range 21 W

Well No. # 2 Carson

Company Solar Oil

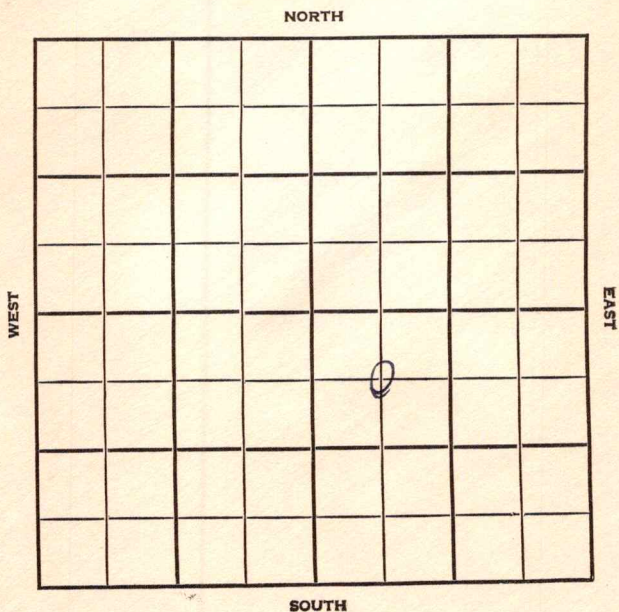

HOT FILE

Clark

KANSAS

SEC.	TWP.	R.
34	33	21W

WELL NO.

2 Carson

FARM

COMPANY

Solar Oil

CONTRACTOR

D&M Drlg.


Harper Ranch Pool

660 Ft. from N. Line

Ft. from S. Line

Ft. from E. Line

660 Ft. from W. Line

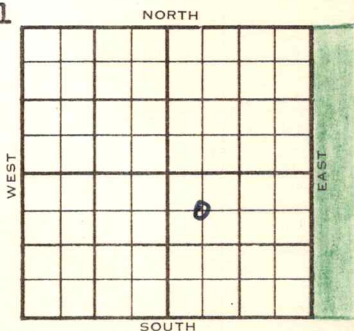

C NW SE


	ELEVATION	REPORT
1954	1896'	

11/17 Spud 11-14-54
20" @ 82'
Drlg. 310'

1955
1/12 Spud 11-14-54 Oil well TD 5563'
20" @ 82 ~~82~~ 8" @ 2370 **Lans 4554**
Morrow 5374 DST 5387-5402 open 1 hr
rec 270' gas, 10' GCM, 235#
DST 5404-36, open 15 min gas in 2
min, oil to surface in 7½ min, rec
1000' oil 1945#
DST 5440-74 open 15 min, gas in 2 min
2,190,000 CFG, oil to surface in 8 min.
rec 1420' oil 1965#
DST 5485-5508 open 1 hr rec 3' mud.
55# **Miss 5510'** TD 5563 5" @ 5563
CO 105/5418-43 F/167 BO 3½ hr.
Comp. BHB 3000 BOPD

COMPLETED


County Clark State Kansas
 Sec. 34 (Blk.) 33 (Sur.) 21W Map No.
 Operator Solar Oil
 Well No. 2 Farm Carson
 Elev. 1896 Location C NW SE

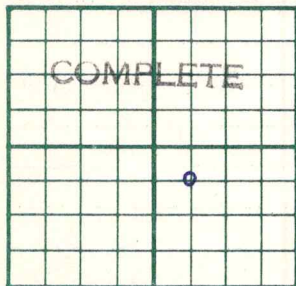

660 Ft. From N Line SE
660 Ft. From W Line Quarter
 1st. Report
 Completion JAN 1 2 1955
 Remarks Harper Ranch Pool
D & M Drlg. - Contr.
 Spudding Date 11-14-54

Drlg. Data Oil well TD 5563
20" @ 82 8" @ 2370 Lans. 4554
Morrow 5374 DST 5387-5402 open 1 hr.
Rec. 270' gas 10' gcm 235#
DST 5404-36 open 15 min. gas in 2 min.
oil to surface in 7 $\frac{1}{2}$ min. Rec. 1000' oil
1945# DST 5440-74 open 15 min. gas in
2 min. 2,190,000 cfg oil to surface in
8 min. Rec. 1420' oil 1965#
DST 5485-5508 open 1 hr. Rec. 3' mud
55# Miss. 5510 TD 5563 5" @ 5563
CO 105/, 5418-43 F/ 167 bo 3 $\frac{1}{2}$ hr.
Comp. BHB 3000 bopd

FABEN GILSTRAP

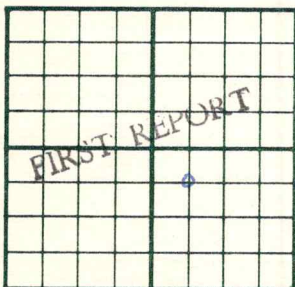County **Clark** State **Kansas**Sec. **34** (Blk.) **33** (Sur.) **21W** Map No.Operator **Solar Oil**Well No. **2** Farm **Carson**Elev. Location **C NW SE****660** Ft. From **N** Line **SE****660** Ft. From **W** Line Quarter1st. Report **NOV 17 1954**

Completion

Remarks

D & M Drlg. - Contr.Spudding Date **11-14-54**Drlg. Data **Harper Ranch Pool****20" @ 82 drlg. 310**

FABEN GILSTRAP