


DX 78-1

Clark **KANSAS**

Section 34 Township 33 Range 21 W

Well No. # 13 J. C. Harper

Company United Production

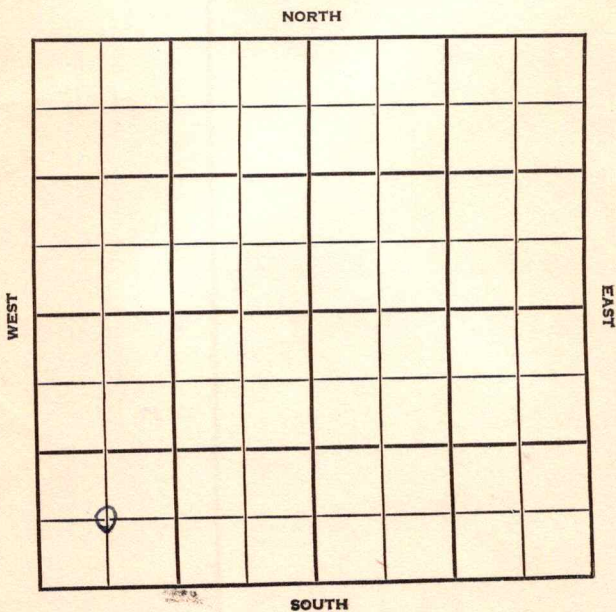

County Clark State Kansas

Sec. 34 (Blk. Twp.) 33 (Sur. Rge.) 21W Map No.

Operator United Production

Well No. 13 Farm J. C. Harper

Elev. Location C SW SW

FIRST REPORT

660 Ft. From S Line SW

660 Ft. From W Line Quarter

1st. Report JAN 5 1955

Completion _____

Remarks _____

Rine Drlg. - Cantr.

Spudding Date 1-1-54

Drlg. Data Harper Ranch Pool

20" @ 63 drlg. 110

