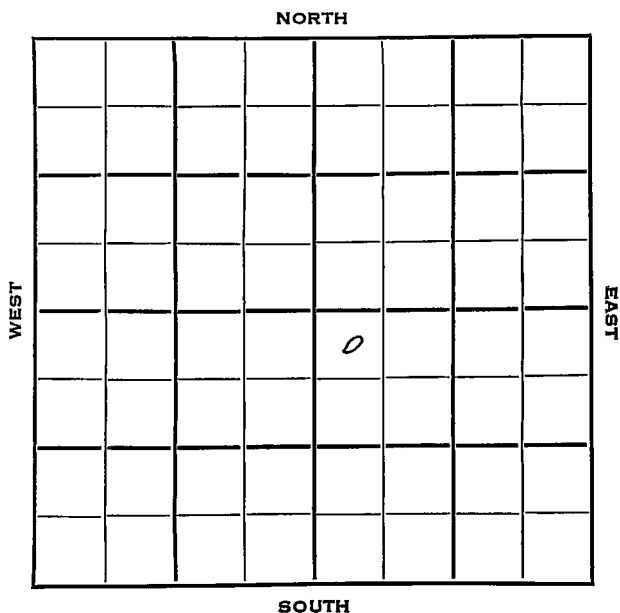


Morton

KANSAS

Section 21 Township 33 Range 42WWell No. #1 Drossellmeyer "A"Company Cities Service

Morton

21

33

42W

Sec. _____ Twp. _____ R. _____

#1 Drossellmeyer "A"

Well No. _____ Farm _____

Cites Service

Company _____

Wildcat

Contractor _____

330

Ft. from N. Line


Ft. from S. Line

Ft. from E. Line

330

Ft. from W. Line

NW NW SE

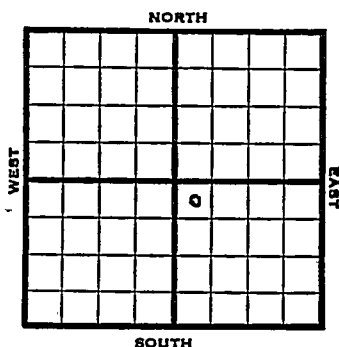

1953

Elev. 3527' REPORT

1/28 Location

2/5 "

2/12 8" @ 322

Top 2930

DST 2968-3000, 1½ hrs.,

416,000, 92' gcm, 480#

2/19 RTD 3440

5" @ 3440

Lans 3165

2/26 N.R.

3/12 NR

3/19 NR.

3/26 Testing

4/2 "

4/9 "

4/16 "

4/22 Gas Well

TD 3440'

8" @ 322

Top 2930,

DST 2968-3000 open 1½ hr. Rec 416,000

gas 92' gcm 480#

TD 3440'

5" @ 3440'

$$\begin{array}{r}
 3527 \\
 2930 \\
 \hline
 + 597 \\
 \hline
 3527 \\
 3165 \\
 \hline
 + 362 \\
 \hline
 \end{array}$$

OVER

1953

Information brought forward

4/22

Lans 3165

CO to 3390 60/ 3312-24 35/ 3288-95

50/ 3254-64 357,000 gas 30/ 3232-38

25/ 3221-26 100/ 3196-3212 672,000

gas 20/ 3186-90 60/ 3170-82 7000 A

7,830,000 gas 6000 A 8,150,000

gas PB 3145 55/ 3113-24 40/ 3090-

98 20/ 3072-76 110/ 3044/66

2,120,000 gas 4000 A 13,700,000 gas

6000 A CO to 3390 15½ mcfg PB 3026

30/ 3000 -04 50/ 2974-84 30/ 2956-

62 30/ 2940-46 80/ 2916-32

4000 A 3,360,000 gas 6000 A

CO to 3390

19 mcfg 10,000 A

Comp. 26,600,000

COMPLETED.

County Morton State Kansas

Sec. **21** (Blk. **33** (Sur. **42W** Map No.

Operator Cities Service

Well No. **1** Farm **Drossellmeyer "A"**

Elev.	Location	NW	NE	SE
-------	----------	----	----	----

FIRST REPORT

330 Ft. From ^N Line SE

330 Ft. From Line Quarter

1st. Report JAN 28 1953

Completion

Remarks

Spudding Date _____

Drig. Data Wildcat

Location

J. G. McGEHEE