
FORM 51 Morton KANSAS

Section 21 Township 33 Range 43 W

Well No. # 1 Bradshaw "A"

Company ~~Cities Service~~

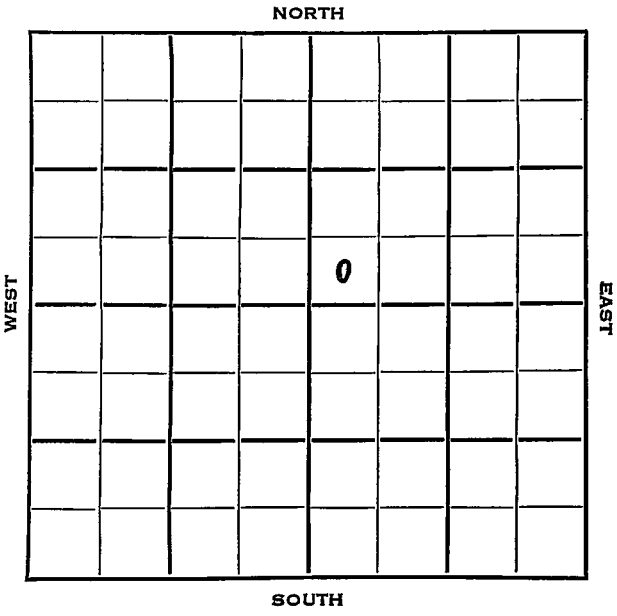

FORM 252-B

Morton KANSAS

Sec. 21 Twp. 33 R. 43 W

Well No. # 1 Bradshaw "A" Farm

Cities Service Company

Contractor

Greenwood Pool


Ft. from N. Line

330 Ft. from S. Line

Ft. from E. Line

330 Ft. from W. Line

SW SW NE

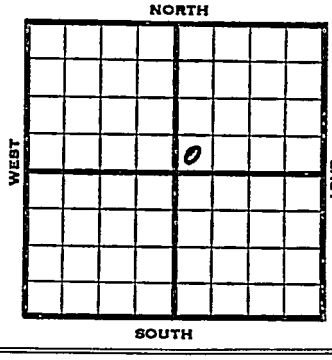

1953	Elev. 3643' REPORT
8/5	Location
8/12	RUR
8/19	8" @ 600' Drlg 2695' 3643 − 2950 = 693 3643 − 3176 = 467 3643 − 2950 = 693
8/26	RTD 3300 Schl 5" @ 3299 CO 3265 20/3258-62, 25/3242-47, 20/3198-3202, 40/3176-84, 4000A S/1200 gwph
9/2	Top 2950', Lans 3176'
9/9	NR
9/23	Spud 8-11-53 Gas well TD3300 8" @ 600 TD 3300 5" @ 3299 CO to 3265 20/3258-62 25/3242-47 20/3198-3202 40/3176-84 4000 A S/1200 GWPH SP 3113 CO to 3117 30/3064-70 160/3046-58 15/3035-38 5000 A PB 3018 35/2994-3001 40/2952-60 7500 A CO to 3300 4000 A Top. 2950 Lans 3176 Comp. 10,200,000 gas. 428# COMPLETED

FORM 275 FOR SALE BY KANSAS BLUE PRINT CO.


County Morton State Kansas

Sec. 21 (Blk. Twp.) 33 (Sur. Rge.) 43W Map No.

Operator Cities Service

Well No. 1 Farm Bradshaw "A"

Elev. Location SW SW NE

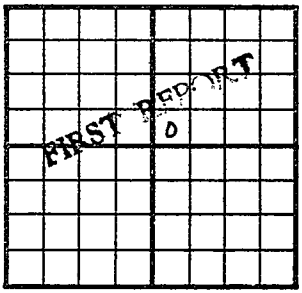

330 Ft. From S Line NE

330 Ft. From W Line Quarter

1st. Report AUG 5 1953

Completion

Remarks

Spudding Date

Drlg. Data Greenwood Pool

Location

J. G. McGEHEE

FORM 275 FOR SALE BY KANSAS BLUE PRINT CO.


County Morton State Kansas

Sec. 21 (Blk. Twp.) 33 (Sur. Rge.) 43W Map No.

Operator Cities Service

Well No. 1 Farm Bradshaw "A"

Elev. 3643 Location SW SW NE

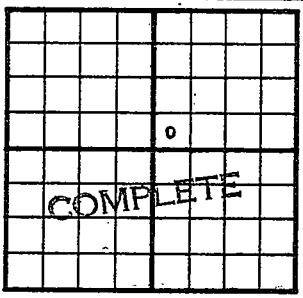

330 Ft. From S Line NE

330 Ft. From W Line Quarter

1st. Report

Completion SEP 23 1953

Remarks Greenwood Gas Pool

Spudding Date 8-11-53

Drlg. Data Gas well TD 3300

8" @ 600 TD 3300 5" @ 3299 CO to 3265

20/ 3258-62 25/ 3242-47 20/ 3198-3202

40/ 3176-84 4000 A S/ 1200 gwph

SP 3113 CO to 3117 30/ 3064-70 160/

3046-58 15/ 3035-38 5000 A PB 3018

35/ 2994-3001 40/ 2952-60 7500 A

CO to 3300 4000 A Top. 2950 Lans. 3176

Comp. 10,200,000 gas 428#

J. G. McGEHEE