


Section 21 Township 33 Range 40 WWell No. # 1 HolcombCompany Panhandle Eastern Pipe Line

NORTH

10

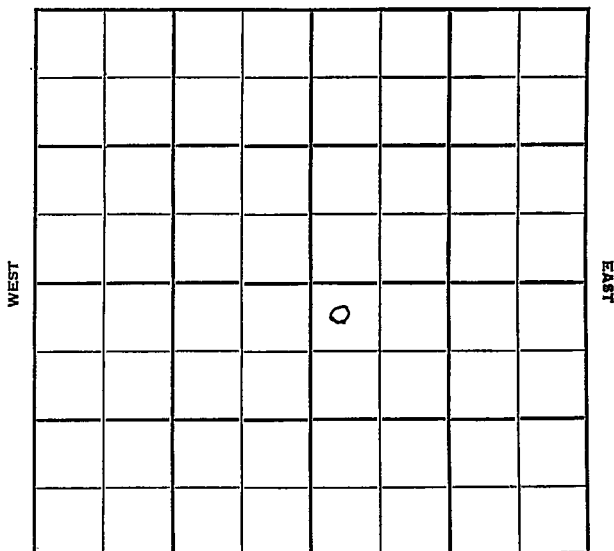

SOUTH

Morton

KANSAS

Sec. 21 Twp. 33 R. 40 W

Well No. # 1 Holcomb Farm

Panhandle Eastern Pipe Line Company

Kuhn Drlg. Contractor


2813 Ft. from N. Line

_____ Ft. from S. Line

2369 Ft. from E. Line

_____ Ft. from W. Line

NW SE

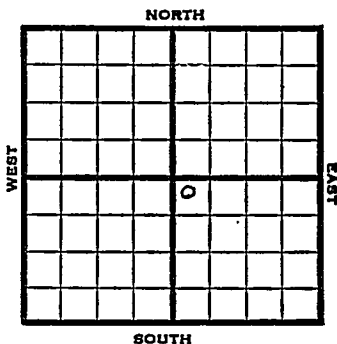

1951

Elev. 3307' REPORT

4/11

Location

5/16

Spud 4-13-51

Gas Well TD 2529

10" @ 470 7" @ 2310

TD 2529 test sw


PB 2437

Her. 2290 Krider 2319

Win. 2387 Ft. Riley 2449

21,000 A Comp. 7,829,000 gas

COMPLETED

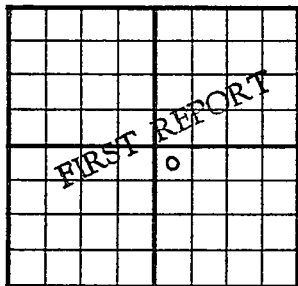County Morton State KansasSec. 21 (Blk. Twp.) 33 (Sur. Rge.) 40W Map No.Operator Panhandle Eastern Pipe LineWell No. 1 Farm HolcombElev. Location NW SE2813 Ft. From N Line SE2369 Ft. From E Line Quarter1st. Report APR 11 1951

Completion

Remarks

Kuhn Drig. - Contr.

Spudding Date

Drig. Data

Location

J. E. TYRA

County Morton State Kansas

Sec. 21 (Blk. Twp.) 33 (Sur. Rge.) 40W Map No.

Operator Panhandle Eastern Pipe Line

Well No. 1 Farm Holcomb

Elev.	3307	Location	NW SE
-------	------	----------	-------

COMPLET

2813 Ft. From N Line SE

2369 Ft. From E Line Quarter

1st. Report

Completion **MAY 16 1951**

Remarks

Kuhn Drlg. - Contr.

Spudding Date 4-13-51

Drilg. Data Gas well TD 2529

10" @ 470 7" @ 2310 TD 2529 test sw

PB 2437 Her. 2290 Krider 2319

Win. 2387 Ft. Riley 2449 21000 A

Comp. 7.829.000 gas

J. E. TYRA