


Section 21 Township 33 Range 36W

Well No. #1 Allbritten

Company Republic Natural Gas

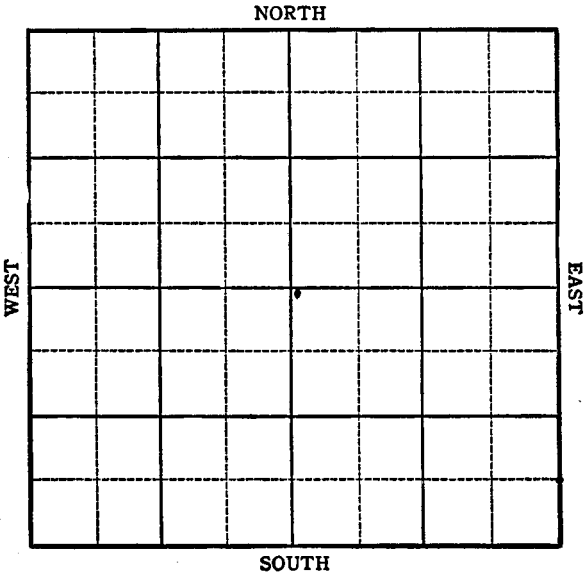

Sec. 21 Twp. 33 R. 36W

Well No. 1 Allbritten Farm

Republic Natural Gas Company

NE SW


NORTH

100 Ft. from N. Line

 Ft. from S. Line

100 Ft. from E. Line

 Ft. from W. Line

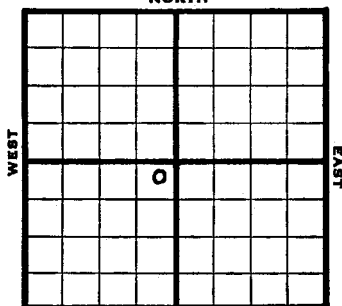

SOUTH

1944

REPORT


9-13	Derrick
9/21	"
9/28	10" @ 523 WOC
10/4	Drlg. 2000
10/11	" "
10/18	Krider 2637 TD
	7" @ 2637 RUST
10/25	" " " " " "
11/1	TD 2836
	214 of 5' perf. liner
	1,019,000 Gas
11/8	9750 acid 4473,000 Gas
1/15	Krider 2636
	7" @ 2636
	214' of 5" Perf. liner @ 2835
	TD 2835
	13000 acid
	12,329,000 Gas.

COMPLETED

Pool Name HugotonMap No. NM Sec. 21 Twp. 33 R. 36WWell No. 1 AllbrittenRepublic Natural Gas Company**COMPLETED**

Contractor

NE SW

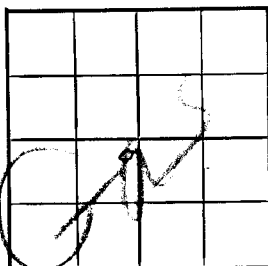SECTION PLAT100 Ft. from N. Line Ft. from S. Line100 Ft. from E. Line Ft. from W. LineStevens County**RECORD**Location Rig up

Drilling and Remarks:

*Kroil 2636**7" @ 2636**214 1/2" 5" Per L. in 12**@ 2735**18000 acial**12,329,000 Gas*Cased in., ft.Sand Gas Oil Total Depth 2835**PRODUCTION**1st 24 hrs. Nat. 1st 24 hrs. after shot Gas Cu. Ft.Dry Hole Abandoned

Date

NOV 15 1944 19

S. J. LEWIS Scout

KANSAS

Pool Name HortonMap No. MM Sec. 21 Twp. 33 R. 36WWell No. 1 Allbritten

Republic Natural Gas Company

FIRST REPORT

Contractor

NE SW

SECTION PLAT

100 Ft. from N. Line Ft. from S. Line100 Ft. from E. Line Ft. from W. Line

		o	

Stevens

Location

RECORD

Rig up

Cased in., ft.

Drilling and Remarks:

Sand Gas Oil Total Depth

Derrick

PRODUCTION

1st 24 hrs. Nat. 1st 24 hrs. after shot Gas Cu. Ft.Dry Hole Abandoned

Date

SEP 13 1944 19

S. J. LEWIS Scout