

STATE CORPORATION COMMISSION OF KANSAS
OIL & GAS CONSERVATION DIVISIONWELL COMPLETION OR RECOMPLETION FORM
ACO-1 WELL HISTORY

DESCRIPTION OF WELL AND LEASE

Operator: license # 5171
name TXO PRODUCTION CORP.
address 200 W. Douglas
Suite 300
City/State/Zip Wichita, Kansas 67202

Operator Contact Person Harold R. Trapp
Phone (316) 265-9441

Contractor: license # 5106
name Freeman Drilling, Inc.

Website Geologist Earl Moore
Phone 775-6521

PURCHASER Dry & Abandoned

Designate Type of Completion
☒ New Well ☐ Re-Entry ☐ Workover

☒ Oil ☐ SWD ☐ Temp Abd
☐ Gas ☐ Inj ☐ Delayed Comp.
☒ Dry *see side two* ☐ Other (Core, Water Supply etc.)

If WO: old well info as follows:
Operator N/A
Well Name N/A
Comp. Date N/A Old Total Depth

WELL HISTORY

Drilling Method: ☒ Mud Rotary ☐ Air Rotary ☐ Cable
11-24-84 12-04-84 12-04-84
Spud Date Date Reached TD Completion Date
5450' Dry
Total Depth PBTD
Amount of Surface Pipe Set and Cemented at 8-5/8" @ 647' feet
Multiple Stage Cementing Collar Used? ☐ Yes ☒ No
If Yes, Show Depth Set N/A feet

If alternate 2 completion, cement circulated
from N/A feet depth to N/A w/ N/A SX cmt

API NO. 15 - 025-20,861

County Clark

SW SW SW Sec 10 Twp 33S Rge 22 East
(location) X West

330' Ft North from Southeast Corner of Section
4950' Ft West from Southeast Corner of Section
(Note: locate well in section plat below)


Lease Name Nunemacher Well# 1

Field Name Ashland East

Producing Formation Dry & Abandoned

Elevation: Ground 1955' KB 1967'

Section Plat

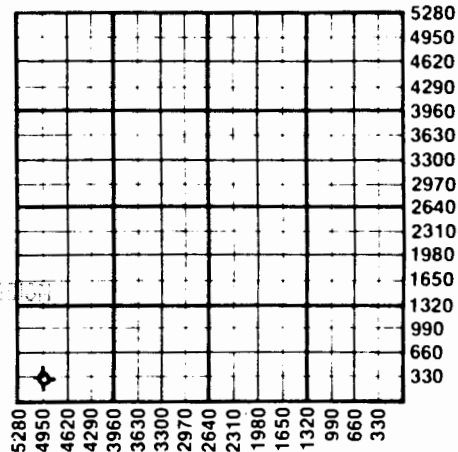

WATER SUPPLY INFORMATION

Source of Water:
Division of Water Resources Permit # N/A
☐ Groundwater N/A Ft North From Southeast Corner and
(Well) Ft. West From Southeast Corner of
Sec Twp Rge ☐ East ☐ West
☐ Surface Water N/A Ft North From Southeast Corner and
(Stream, Pond etc.) N/A Ft West From Southeast Corner
Sec Twp Rge ☐ East ☐ West
☐ Other (explain) N/A
(purchased from city, R.W.D.#)

Disposition of Produced Water: ☐ Disposal ☐ Repressuring

Docket # N/A

INSTRUCTIONS: This form shall be completed in duplicate and filed with the Kansas Corporation Commission, 200 Colorado Derby Building, Wichita, Kansas 67202, within 90 days after completion or recompletion of any well. Rules 82-3-130 and 82-3-107 apply.

Information on side two of this form will be held confidential for a period of 12 months if requested in writing and submitted with the form. See rule 82-3-107 confidentiality in excess of 12 months.

All wireline logs and drillers time log shall be attached with this form. Submit CP-4 form with all plugged wells. Submit CP-111 form with abandoned wells.

SIDE TWO

Operator Name TXO PRODUCTION CORP. Lease Name Nucemacher. Well# 1. SEC 10. TWP 33S RGE 22

WELL LOG

INSTRUCTIONS: Show important tops and base of formations penetrated. Detail all cores. Report all drill giving interval tested, time tool open and closed, flowing and shut-in pressures, whether shut-in pressure reached stat level, hydrostatic pressures, bottom hole temperature, fluid recovery, and flow rates if gas to surface during test. Attach extra sheet if more space is needed. Attach copy of log.

Drill Stem Tests Taken ☒ Yes ☐ No
 Samples Sent to Geological Survey ☒ Yes ☐ No
 Cores Taken ☐ Yes ☒ No

Formation Description
☒ Log ☐ Sample

Name Top Bottom

DST #1, 5278-5340' (Morrow Sand)
 IFP/30"=51-51#, weak blow
 ISIP/60"=142#
 Rec: 70' DM No show

Ran O.H. Logs

Herington	2329'	- 362'
Heebner	4209'	-2242'
Toronto	4229'	-2262'
Iatan	4404'	-2437'
Lansing	4415'	-2448'
Stark	4853'	-2886'
Swope	4862'	-2895'
B/KC	4972'	-3005'
Cherokee	5168'	-3201'
Morrow	5258'	-3291'
Morrow Sd	5304'	-3337'
Miss.	5348'	-3381'
RTD	5450'	
LTD	5450'	

CASING RECORD

☒ new ☐ used

Report all strings set - conductor, surface, intermediate, production, etc.

Purpose of string	size hole drilled	size casing set (in O.D.)	weight lbs/ft.	setting depth	type of cement	# sacks used	type and percent additives
Surface	12-1/4"	8-5/8"	23#	689'	Lite Class "A"	375 sxs 100 sxs	

PERFORATION RECORD

Acid, Fracture, Shot, Cement Squeeze Record

shots per foot	specify footage of each interval perforated	(amount and kind of material used)	Depth
NONE	NONE	NONE	