


Section 22 Township 33 Range 42 W

Well No. # 1 Hentschel "A"

Company Cities Service Oil

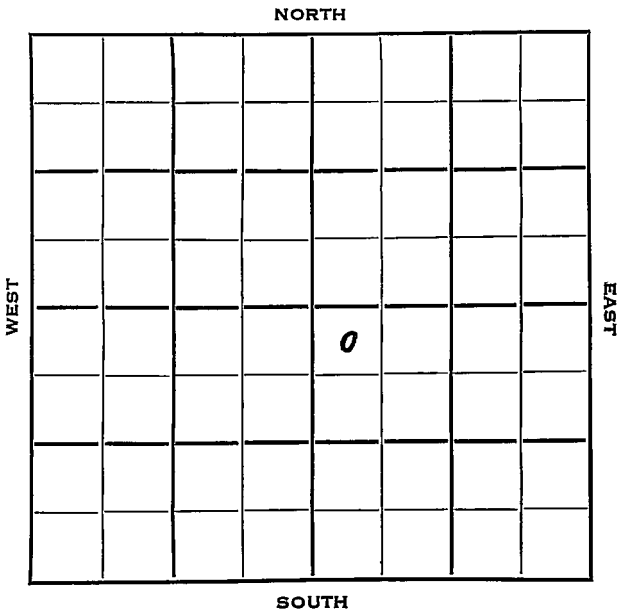

Morton

KANSAS

SEC.	TWP.	R.
22	33	42 W

WELL NO.

1 Hentschel "A"

FARM

COMPANY

Cities Service Oil

CONTRACTOR

Greenwood Gas

330

Ft. from N. Line


Ft. from S. Line

Ft. from E. Line

330

Ft. from W. Line

NW NW SE

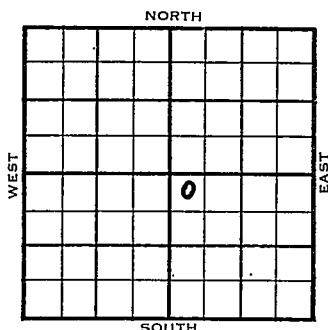

1953

ELEVATION

3503'

REPORT

9/16

Spud 9-12-53

8" @ 600

Drlg. 705'

9/23

RTD 3315'

5" @ 3313'

9/30

Anhy 1366' Tor 2922' Lans 3150'

RUST

10/28

Spud 9-12-53 Gas well TD 3315

8" @ 600 Anhy 1366 Top. 2922'

Lans 3150 TD 3315 5" @ 3313

CO to 3277 40/3244-52 30/3232-38

115/3205-28 70/3182-96 2000 A

SP 3170 40/3146-54 5,350,000 gas

30/3136-42 20/3128-32 2500 A

6½ MCFG 3000 A CO to 3277

7,150,000 SP 3111 30/3086-92

140/3054-82 2,220,000 gas 5000 A

18,900,000 gas 1000 A CO to 3277

14,400,000 gas. SP 3031 30/3010-14

50/2958-28 40/2962-70 40/2948-56

80/2924-40 6000 A 3000 A

6000 A CO to 3277

Comp. 26,600,000 gas 434#

3503' 3503'
 2922' 3150'
 + 583 355'

COMPLETED

Map No.

Hentschel "A"

NW NW SE

[illegible]

SE

Quarter

1st. Report

OCT 28 1953

Greenwood Pool

9-12-53

Gas well

Top. 2922

CO to

30/ 3232-38

2000 A

5.350.000 gas

2500 A

7.150.000

140/ 3054-82

18,900,000 gas

14,400,000 gas

50 / 2958-28

80 / 2924-40

CO to 3277

434#

J. G. McGEHEE

County Morton State Kansas

Sec. 22 (Blk. Twp.) 33 (Sur. Rge.) 42W Map No.

Operator Cities Service Oil

Well No. 1 Farm Hentschel "A"

Elev.	Location	NW	NE	SE
-------	----------	----	----	----

FIRST REPORT	
	0

330 Ft. From N Line SE

330 Ft. From W Line Quarter

1st. Report SEP 16 1953

Completion

Remarks

Spudding Date 9-12-53

Drig. Data Greenwood Gas

8" @ 600 drlg. 705