

FORM 51


Morton

KANSAS

Section 22 Township 33 Range 43W

Well No. #1 Hart "A"

Company Oities Service

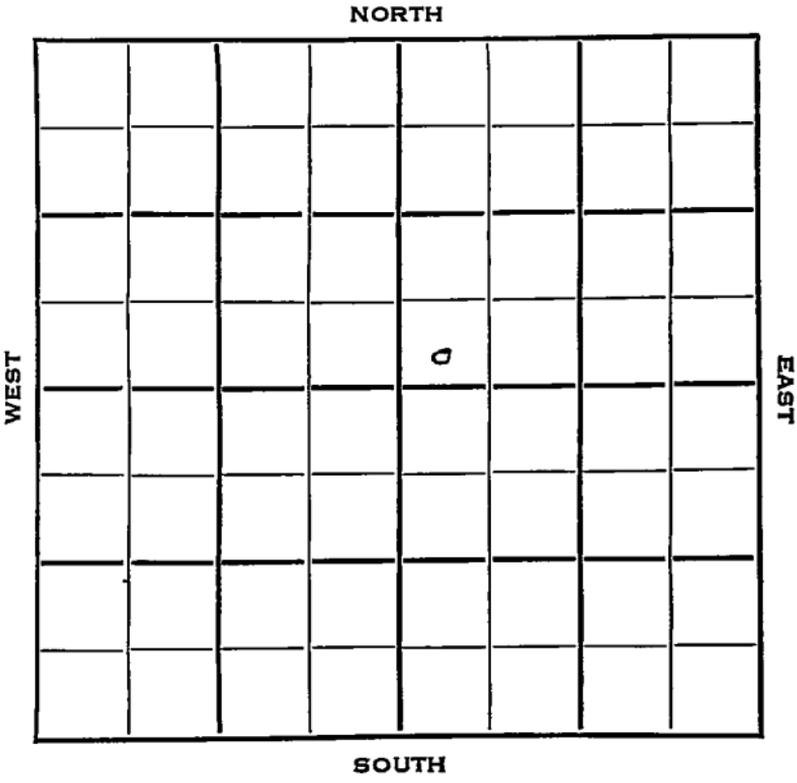

Morton
33

KANSAS
43W

Sec. 22 Twp. R.

Well No. #1 Hart "A" Farm

Cities Service

Company

Contractor

Ft. from N. Line

330


Ft. from S. Line

Ft. from E. Line

330

Ft. from W. Line

SW SW NE

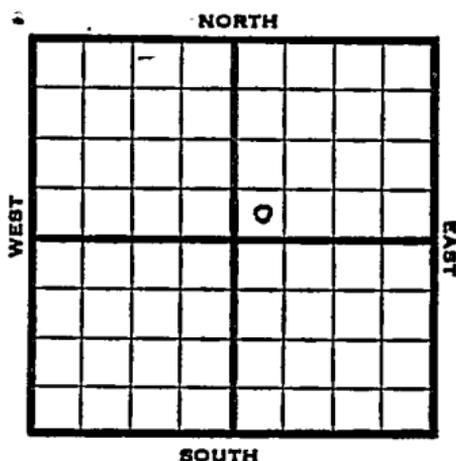

1953

Elev. 3622' REPORT

1/28 Location

2/5 8" @ 332
Drlg. 2050'

2/12 DST 2993-3018, 1 1/2 hrs., gauge
100,000 gas, 25' GCM, 495#
RTD 3425,
5" @ 3416
Top 2902, Lans 3158

2/19 NR

2/26 N.R.

3/12 NR

3/18 Spud 1-31-53 Gas well TD 3425
8" @ 332

DST 2993-3018 open 1 1/2 hr. rec 25'
GCM, 100,000 gas 495#

TD 3425 5" @ 3416 Top 2902

Lans. 3158 120/3290-3314

50/3276-86 50/3262-72 60/3228-40

70/3210-24 70/3192-3206

20/3182-86 30/3172-78 30/3160-66

7500 A 800 GSWPH SP 3246

Re-set plug 3132' CO to 3180


~~50/3276-86 50/3262-72 60/3228-40~~

3622
2902
+720

3422
3158
+464

OVER

County Morton State Kansas
 Sec. 22 (Blk.) 33 (Sur.) 43W Map No.
 Operator Cities Service
 Well No. 1 Farm Hart "A"
 Elev. 3622 Location SWSW NE

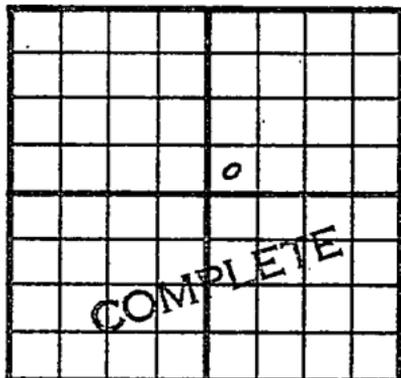

330 Ft. From S Line NE

330 Ft. From W Line Quarter

1st. Report

Completion MAR 18 1953

Remarks

Spudding Date 1-31-53

Drlg. Data Gas well TD 3425
 8" @ 332 DST 2993-3018 open $1\frac{1}{2}$ hr.
 Rec. 25' gcm 100,000 gas 495#
 TD 3425 5" @ 3416 Top. 2902
 Lans. 3158 120/ 3290-3314 50/ 3276-86
 50/ 3262-72 60/ 3228-40 70/ 3210-24
 70/ 3192-3206 20/ 3182-86 30/ 3172-78
 30/ 3160-66 7500 A 800 gswph SP 3246
 reset plug 3132 CO to 3180 CO to 3233
 90/ 3212-30 24/ 3218-24 50/ 3194-3202
 16/ 3197-3201 20/ 3182-86 4000 A
 S/ 250 gswph SP 3146 CO to 3146
 100/ 3030-50 20/ 3016-20 3000 A
 3,750,000 gas 18 hr. blow down
 4,000,000 gas PB 2999 30/ 2990-96

J. G. McGEHEE

Drlg. Data

60/ 2970-82 50/ 2950-60 60/ 2930-42

60/ 2906-18 20 min. 9,600,000 gas

3000 A 1500 A CO to 3144 1500 A 3000

Comp. 14 mcf/gpd 425#

MARK 2 4 1953

SCOUT CARDS
LAND ORIGIN MAP
LAND MAP
TRACINGS
FRANCE MAP
PRICE MAP
INDEX

