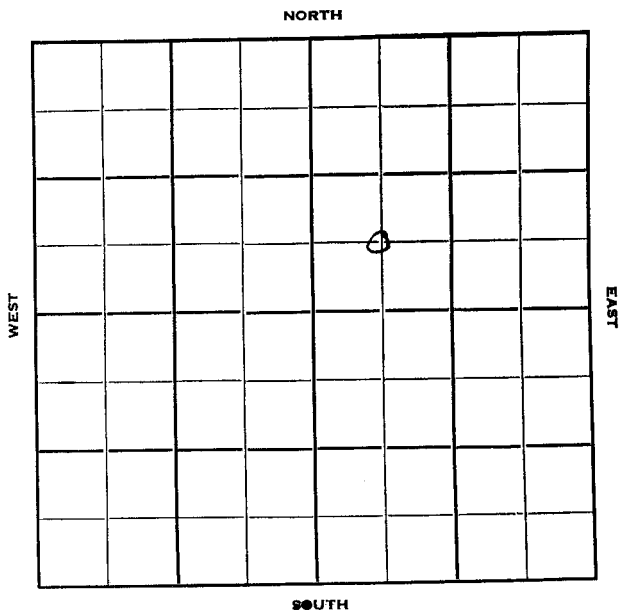


Section 22 Township 33 Range 31-WWell No. #1 McVeyCompany Stanolind

22

33

31-W

Sec. _____ Twp. _____ R. _____

#1 McVey

Well No. _____ Farm _____

Stanolind

Company _____

Wildcat _____ Contractor _____

Ft. from N. Line

NORTH

660


Ft. from S. Line

Ft. from E. Line

660

Ft. from W. Line

C SW NE

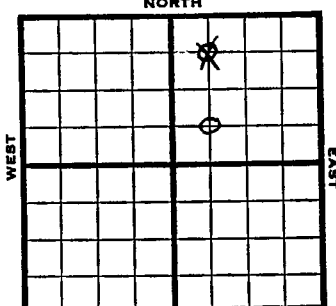

Core drill & seismograph

SOUTH

1951

Elev. 2740' REPORT

1/10

RUR

Miss test

4/18

Spud 1-18-51

D&A TI 6120

13" @ 650 9" @ 2428

IST 4080-4200 opn 1 hr

Rec. 540' mud 1740' sw

Ians. 4421

Cored 4440-51 Rec. 11' dense
limestoneCored 4451-85 Rec. 34' limestone
& SSO 4457-62 SO & por
4466-68 SSO in limestoneDST 4450-85 opn 1 hr Rec. 1022' drlg
mudCored 4485-4521 Rec. 34' limestone
2' sh DST 4458-4521 opn 1 hr

Rec. 620' mud 175' sw

DST 4457-62 opn 1/2 hr Rec. 692' mud
175' sw DST 4575-4605 opn 1 hr

Rec. 75' mud 720' water

DST 5052-72 opn 1 hr Rec. 218' gas
& ocm

DST 5241-70 opn 1 hr Rec 780' mud

DST 5645-5765 opn 1 hr Rec. 75' mud

DST 5882-5902 opn 1 hr Rec. 1620' mu
& SOCM DST 5934-54 opn 1 hr Rec 15'
g & ocm 45' sw DST 6014-72 opn

1 hr Rec. 365' mud 3' salty ocm

TD 6120 D&A

OVER

1951 (Information brought forward)

4/18 Schlumberger tops:

Lans. 4437 Marmaton 4564

Cherokee 5234 Miss 5584

St. Gen. 5676

ABANDONED


County **Seward** State **Kansas**

Sec. **22** (Blk. Twp.) **33** (Sur. Rge.) **31W** Map No.

Operator **Stanolind**

Well No. **1** Farm **McVey**

Elev. Location **C SW NE**

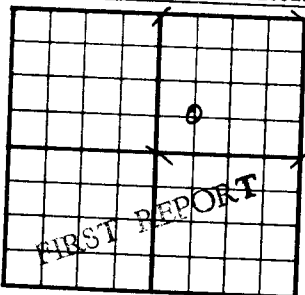

660 Ft. From **S** Line **NE**

660 Ft. From **W** Line Quarter

1st. Report **JAN 10 1951**

Completion

Remarks **Miss. test**

Core drill & seismograph

Spudding Date

Drlg. Data **Wildcat**

R U P


J. E. TYRA

County Seward State Kansas
 Sec. 22 (Blk. Twp.) 33 (Sur. Rge.) 31W Map No.

Operator Stanolind

Well No. 1 Farm McVey

Elev. 2740 Location C SW NE

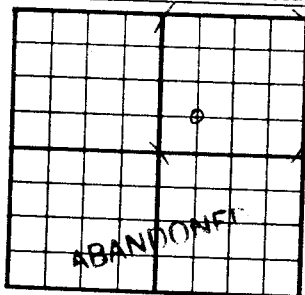

660 Ft. From S Line NE

660 Ft. From W Line Quarter

1st. Report

Completion APR 18 1951

Remarks Wildcat

Spudding Date 1-18-51

Drlg. Data D & A TD 6120

13" @ 650 9" @ 2428 DST 4030-4200

open 1 hr. Rec. 540' mud 1740' sw

Lans. 4421 Cored 4440-51 Rec. 11'

dense limestone Cored 4451-85 Rec. 34'

limestone & SSO 4457-62 SO & per.

4466-68 SSO in limestone DST 4450-85

open 1 hr. Rec. 1022' drls. mud

Cored 4485-4521 Rec. 34' limestone 2' sh.

DST 4458-4521 open $\frac{1}{2}$ hr. Rec. 620' mud

175' sw DST 4457-62 open $\frac{1}{2}$ hr.

Rec. 692' mud 175' sw DST 4575-4605

open 1 hr. Rec. 75' mud 720' water

DST 5052-72 open 1 hr. Rec. 218' gas &

ocm DST 5241-70 open 1 hr. Rec. 780'

J. E. TYRA

Fig. Date

mud DST 5645-5765 open 1 hr. Rec. 75' m

DST 5882-5902 open 1 hr. Rec. 1620' mud

& SOCN DST 5934-54 open 1 hr. Rec. 15'

g & ocm 45' sw DST 6014-72 open 1 hr.

Rec. 365' mud 3' salty ocm TD 6120

D & A

Schlumberger tops:

Lans. 4437 Farmaton 4564

Cherokee 5234 Miss. 5584 St. Gen. 5676

Scout Cards	
Land Small Map	
Land Wall Map	
Findings	
France Map	
Pierce Map	
Misc.	

APR 24 1957