

KANSAS


Seward

Section 22 Township 33 Range 34W

Well No. 1 Etzole

Company Panhandle Eastern

Hugoton

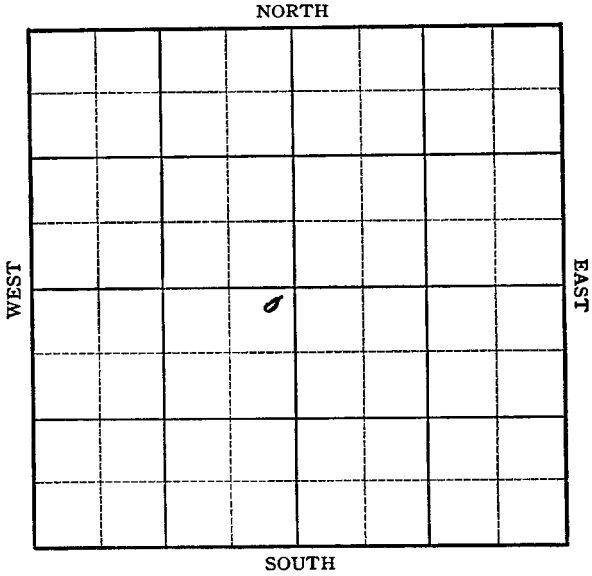

Sec. 22 Twp. 33 R. 34W


Well No. #1 Etzole Farm

Panhandle Eastern

Company

Hugoton Pool (Moran, Cont.)

NORTH

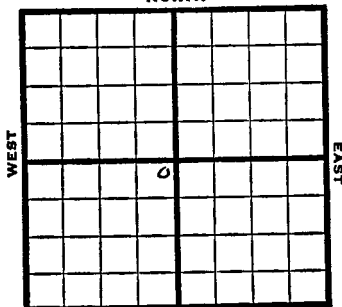

SOUTH

100' Ft. from N. Line

 Ft. from S. Line

100' Ft. from E. Line

 Ft. from W. Line

NE SW

1949 Elev 2900' REPORT

8/10 Drlg . 420'

8/17 10" @ 560'
Drlg. 2477'

8/24 7" @ 2590
TD 2747

175' of 5" Perf Liner @ 2747',

8/31 TD 2747'

7" @ 2590'

175' of 5" Perf Liner @ 2747'

1,391,000 Gas

437# R Pr.

Comp

COMPLETED

Map No. _____ Sec. 22 Twp. 33 R. 34W

Well No. 1 Etzole

Panhandle Eastern

Company

Moran

Contractor

NE SW


**FIRST REPORT
SECTION PLAT**

100 Ft. from N. Line

_____ Ft. from S. Line

100 Ft. from E. Line

_____ Ft. from W. Line

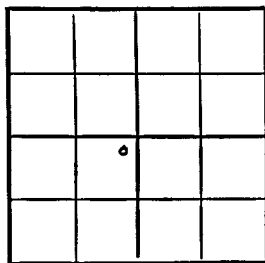

Seward County

RECORD

Location _____

Cased _____ in., _____ ft.

Rig up _____

Sand _____

Drilling and Remarks:

Gas _____

Oil _____

drlg. 420'

Total Depth _____

PRODUCTION

1st 24 hrs. Nat. _____

1st 24 hrs. after shot _____

Gas _____ Cu. Ft.

Dry Hole _____

Abandoned _____

Date

AUG 10 1949 19

S. J. LEWIS

Scout

Map No. ✓ Sec. 22 Twp. 33 R. 34W

Well No. 1 Etzole

Panhandle Eastern

Company

COMPLETE

NE SW

Contractor


E1.2908
SECTION PLAT

100 Ft. from N. Line

_____ Ft. from S. Line

100 Ft. from E. Line

_____ Ft. from W. Line

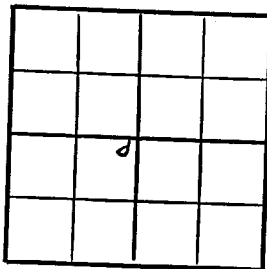

Seward County

Location _____

Rig up _____

Drilling and Remarks:

7" @ 2540

175270" Dry line

C2747

1,391,000 Gall

482* R/P

RECORD

Cased _____ in., _____ ft.

Sand _____

Gas _____

Oil _____

Total Depth 2747

PRODUCTION

1st 24 hrs. Nat. _____

1st 24 hrs. after shot _____

Gas _____ Cu. Ft.

Dry Hole _____

Abandoned _____

Date

AUG 31 1949

19

S. J. LEWIS

Scout