

STATE CORPORATION COMMISSION OF KANSAS  
OIL & GAS CONSERVATION DIVISION  
WELL COMPLETION OR RECOMPLETION FORM  
ACO-1 WELL HISTORY  
DESCRIPTION OF WELL AND LEASE

Operator: License # 3732  
Name Contract Operations, Inc.  
Address P. O. Box 83  
Great Bend, KS 67530  
City/State/Zip Great Bend, KS 67530

Purchaser.....

Operator Contact Person Norman Brandeberry...  
Phone 316-792-3033

Contractor: License # 5107  
Name H-30 Drilling, Inc.

Wellsite Geologist.....  
Phone.....

Designate Type of Completion  
 New Well  Re-Entry  Workover

Oil  SWD  Temp Abd  
 Gas  Inj  Delayed Comp.  
 Dry  Other (Core, Water Supply etc.)

If ONWO: old well info as follows:  
Operator.....  
Well Name.....  
Comp. Date.....Old Total Depth.....

Drilling Method:  
 Mud Rotary  Air Rotary  Cable

Spud Date 11/16/88 Date Reached TD 12/1/88 Completion Date 12-2-88

Total Depth 7050' PBTD

Amount of Surface Pipe Set and Cemented at 774 feet  
Multiple Stage Cementing Collar Used?  Yes  No  
If yes, show depth set.....feet  
If alternate 2 completion, cement circulated from.....feet depth to.....w/.....SX cmt  
Cement Company Name.....  
Invoice #.....

API No. 15-025-21,018  
County Clark  
SE NE Sec 17 Twp 33S Rge 23 East West

3300 Ft North from Southeast Corner of Section  
660 Ft West from Southeast Corner of Section  
(Note: Locate well in section plat below)


Lease Name Rhoades "K" Well # 1

Field Name.....

Producing Formation.....

Elevation: Ground 2026 KB 2037

Section Plat

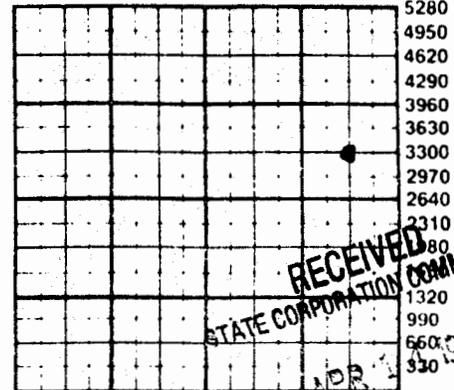

RECEIVED  
STATE CORPORATION COMMISSION

DEC 9 1988

CONSERVATION DIVISION  
Wichita, Kansas

RECEIVED  
STATE CORPORATION COMMISSION

APR 21 1989

WATER SUPPLY INFORMATION

Disposition of Produced Water:  Disposal  Repressuring  
Docket #.....

Questions on this portion of the ACO-1 call:

Water Resources Board (913) 296-3717  
Source of Water:  
Division of Water Resources Permit #.....

Groundwater.....Ft North from Southeast Corner (Well) .....Ft West from Southeast Corner of Sec Twp Rge East West

Surface Water.....Ft North from Southeast Corner (Stream, pond etc).....Ft West from Southeast Corner Sec Twp Rge East West


Other (explain)..... (purchased from city, R.W.D. #)

INSTRUCTIONS: This form shall be completed in triplicate and filed with the Kansas Corporation Commission, 200 Colorado Derby Building, Wichita, Kansas 67202, within 120 days of the spud date of any well. Rule 82-3-130, 82-3-107 and 82-3-106 apply. Information on side two of this form will be held confidential for a period of 12 months if requested in writing and submitted with the form. See rule 82-3-107 for confidentiality in excess of 12 months. One copy of all wireline logs and drillers time log shall be attached with this form. Submit CP-4 form with all plugged wells. Submit CP-111 form with all temporarily abandoned wells.

All requirements of the statutes, rules and regulations promulgated to regulate the oil and gas industry have been fully complied with and the statements herein are complete and correct to the best of my knowledge.

Signature Norman W Brandeberry  
Title Authorized Agent Date 12/24/88

Subscribed and sworn to before me this 26th day of December 1988  
Notary Public Linda Pearson  
Date Commission Expires 7-20-92

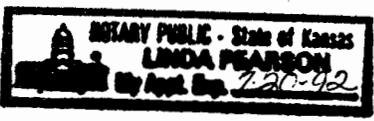

K.C.C. OFFICE USE ONLY  
 Letter of Confidentiality Attached  
 Wireline Log Received  
 Drillers Timelog Received  
Distribution  
 KCC  SWD/Rep  NGPA  
 KGS  Plug  Other (Specify)

Sec 17 Twp 33 Rge 23