


Section 23 Township 33 Range 42W

Well No. #1 Kipnes

Company Cities Service Oil

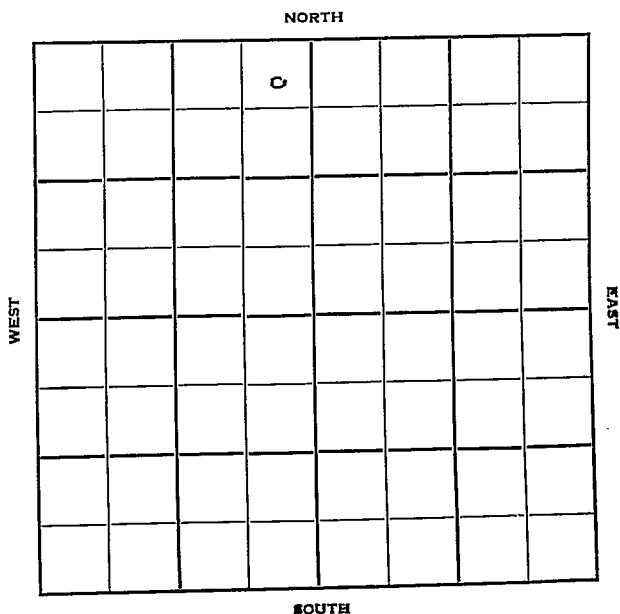

Sec. 23 Twp. 33 R. 42WWell No. #1 Kipner Farm _____

Cities Service Oil Company

Wildcat


330 Ft. from N. Line

Ft. from S. Line

330 Ft. from E. Line

Ft. from W. Line

NE NE NW

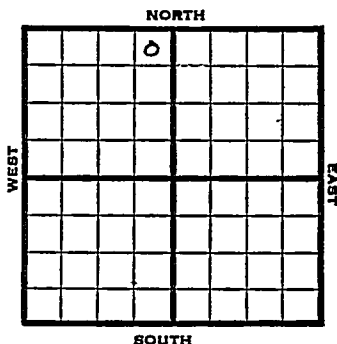

1952

3498

REPORT

Miss. Test

10/15 Spud 10-11-52
12" @ 334'
Drlg. 1355'10/22 Topeka 2946' Lans. 3203'
Schl 3340' Drlg.10/29 8" @ 3619'
Drlg. 3960'11/5 DS¹ 4522-33, 1 hr., 150,000
gas, 30' SGCM
DST 4826-36, 1 hr., 40' GCM +
52 dist
Drlg. 5136'11/12 TD 5165'
DST 5098-5165, 3/4 hr, 15' M 300#
5" @ 5140 Marm 3600' Cherokee 3820'
Morrow 4420' Chester 4972'
St. Gen 5042'11/20 1/3700 Sq CO 5000 50/4946-56
50/4926-36

LL/27 Testing

12/4 3000A
110/4282-4804

12/11 Testing

12/18 Testing

12/25 Testing

$$\begin{array}{r} 3498 \\ 2946 \\ \hline 552 \end{array}$$
$$\begin{array}{r} 3498 \\ 3203 \\ \hline 285 \end{array}$$
$$\begin{array}{r} 3498 \\ 2946 \\ \hline 552 \end{array}$$
$$\begin{array}{r} 4972 \\ 3498 \\ \hline 1474 \end{array}$$

OVER

1953

#1 Kipner

1/1 Testing

1/8 Testing

1/22 "

1/29 "

2/5 "

2/12 "

2/25 Spud 10-11-52

Gas Well

TD 5165

12 @ 334

Top 2946, 1 ans 3203

8 @ 3619

TD 3620

DST 4522-33, opn 1 hr., rec.

150,000 gas, 30' sgcm, 1380#

DST 4826-36, opn 1 hr., 2,420,000

gas, 40' gcm SS Dist. 1125#

TD 5165

DST 5098-5165, opn 3/4 hrs.,

rec. 15' mud, 300#

5 @ 5040

Marm 3600, Cherokee 3820,

Morrow 4420, Chester 4972,

St. Gen. 5042

1/3700 CO to 5000

50/4946-56, 50/4926-36, 1000A

S/500 gswph CO to 4901

60/4818-30, 1000A, 3000A

110/4782-4804, 4500A

2,740,000 gas, 3000A

4,300,000 gas 1000A

SP 4560


60/4534-44, 250A

Comp. 9 mcf/gpd

COMPLETED

4534
3496
-1036

County Morton State Kansas
 Sec. 23 (Blk. 33) (Sur. 42W) (Twp.) Map No.
 Operator Cities Service Oil
 Well No. 1 Farm Kipner
 Elev. 3498 Location NE NE NW

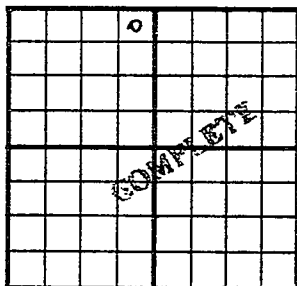

330 Ft. From N Line NW
330 Ft. From E Line Quarter
 1st. Report
 Completion FEB 25 1953
 Remarks Wildcat
 Spudding Date 10-11-52

Drlg. Data Gas well TD 5165
 12" @ 334 Top. 2946 Lans. 3203
 8" @ 3619 TD 3620 DST 4522-33 open 1 hr
 Rec. 150,000 gas 30' sgcm 1380#
 DST 4826-36 open 1 hr. 2,420,000 gas
 40' gcm SS dist. 1125# TD 5165
 DST 5098-5165 open 3/4 hr. Rec. 15' mud
 300# 5" @ 5040 Marm. 3600
 Cherokee 3820 Morrow 4420 Chester 4972
 St. Gen. 5042 1/ 3700 CO to 5000
 50/ 4946-56 50/ 4926-36 1000 A
 S/ 500 gswph CO to 4901 60/ 4818-30
 1000 A 3000 A 110/ 4782-4804 4500 A
 2,740,000 gas 3000 A 4,300,000 gas
 1000 A SP 4560 60/ 4534-44 250 A
 Comp. 9 mcf/gp

J. G. McGEHEE

County Morton State KansasSec. 23 (Blk.) 33 (Sur.) 42W Map No.Operator Cities Service OilWell No. 1 Farm WipnerElev. Location NE NE NW

			0				

330 Ft. From N Line NW330 Ft. From E Line Quarter1st. Report OCT 15 1952

Completion

Remarks Miss. testSpudding Date 10-11-52Drilg. Data Wildcat12" @ 334 drlg. 1355

J. G. McGEHEE