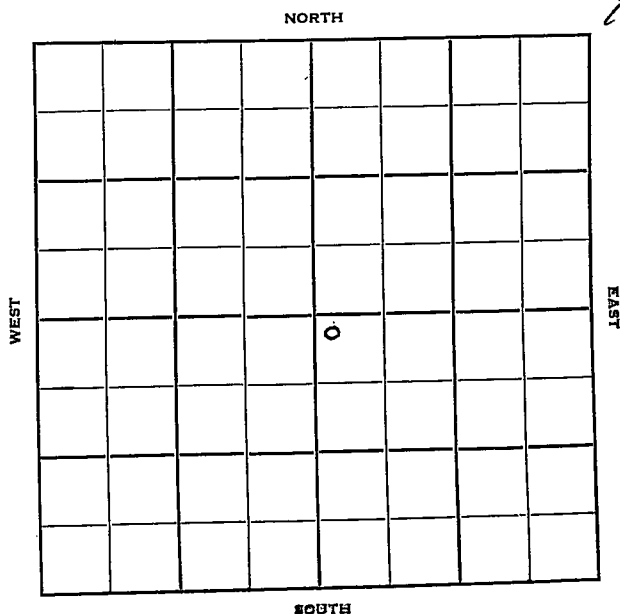


Section 23 Township 33 Range 40WWell No. #1 SimmonsCompany Panhandle Eastern

Morton

KANSAS

Sec. 23 Twp. 33 R. 40W

Well No. #1 Simmons Farm

Panhandle Eastern Company

Contractor

Hugoton Pool

2740' Ft. from N. Line


Ft. from S. Line

2500' Ft. from E. Line

Ft. from W. Line

NW NW SE

Gas Well

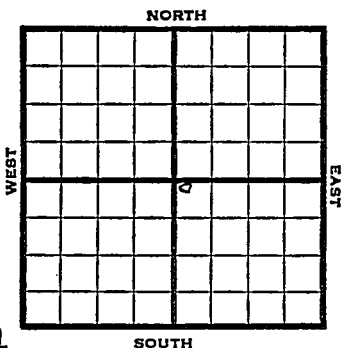

1950

Elev 3289

REPORT

5/3

Spud 4-29-50

10" @ 457'

WOC

10/11

Spud 4-29-50

10" @ 457

7" @ 2387

TD 2582

Her 2394

Krider 2418

Win 2477

Ft. Riley 2545

Comp 965,000 gas Del

Completed

COMPLETED

Kansas

Map No. _____ Sec. 23 Twp. 33 R. 40WWell No. 1 Simmons

_____ Panhandle Eastern _____ Company

_____ Contractor

NW NW SE

SECTION PLAT

2740 Ft. from N. Line

_____ Ft. from S. Line

2500 Ft. from E. Line

_____ Ft. from W. Line



Morton County

Location _____

Rig up _____

Drilling and Remarks:

Spud 4-29-50

10" @ 457 WOC

RECORD

Cased _____ in., _____ ft.

Sand _____

Gas _____

Oil _____

Total Depth _____

PRODUCTION

1st 24 hrs. Nat. _____

1st 24 hrs. after shot _____

Gas _____ Cu. Ft.


Dry Hole _____

Abandoned _____

Date

MAY 3 1950 J. E. TYRA Scout

County Morton State Kansas
 Sec. 23 (Blk. 33) (Sur. 40W) (Twp. Map No.)
 Operator Panhandle Eastern
 Well No. 1 Farm Simmons
 Elev. 3289 Location NW NW SE

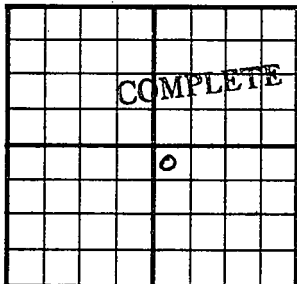

2740 Ft. From N Line Sec.
2500 Ft. From E Line Quarter
 1st. Report
 Completion OCT 11 1950
 Remarks Hugoton Pool
 Spudding Date 4-29-50

Drlg. Data Gas well TD 2582
10" @ 457 7" @ 2387 TD 2582
Her. 2394 Krider 2418 Win. 2477
Ft. Riley 2545 Comp. 965,000 gas Del.

J. E. TYRA