


Form 51-5M-2-29-84703
 Map No. Stevens **KANSAS** Sec. 23 Twp. 33 R. 37^u
 Well No. 1-Brumpton Farm
Argus Sales Company

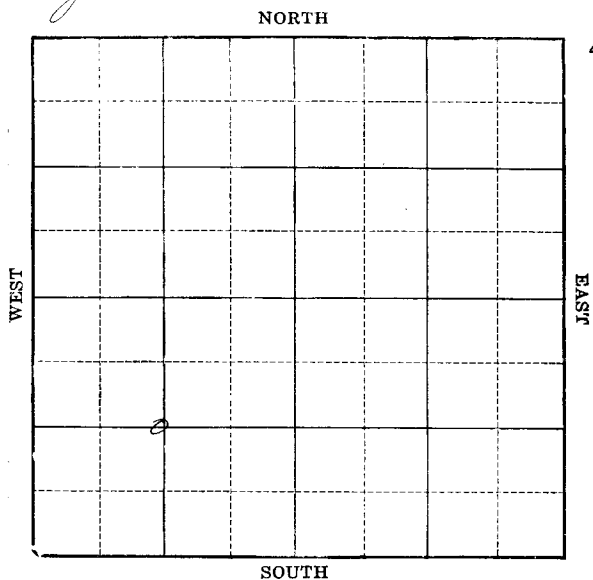

Location _____

Drilling Remarks _____

Rig Up _____

Drilling Remarks _____

RECORD

Cased _____ in. _____ ft.

Sand _____

Gas _____

Oil _____

Total Depth _____

PRODUCTION

1st 24 hrs. Nat. _____

1st 24 hrs. after shot _____

Gas _____ cu. ft.

Dry Hole _____

Abandoned _____

Map No. KANSAS Sec. 23 Twp. 33 R. 37

Well No. 1- Bunyon Farm


Argus Gas Company

Ft. from N. Line

1320 Ft. from S. Line

Ft. from E. Line

1320 Ft. from W. Line

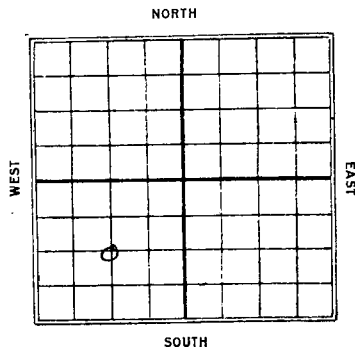

Date 7/23 REPORT

Loc.

Rign up.

12" 616'

Drly 1635'

" 2204'

Rest 2533'

Drly 2790'

No report

Sand 2533-2821

TD 2821

H M gas


Comp.

Map No. KANSAS Sec. 23 Twp. 33 R. 27Well No. 1 Canyon

Company

Contractor

SECTION PLAT

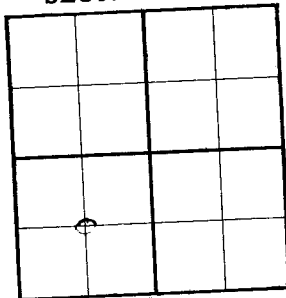

Ft. from N. Line

1020 Ft. from S. Line

Ft. from E. Line

1820 Ft. from W. Line

FIRST REPORTS

Location ✓

Rig up

Drilling and Remarks:

RECORD

Cased _____ in., _____ ft.

Sand _____

Gas _____

Oil _____

Total Depth _____

PRODUCTION

1st 24 hrs. Nat. _____

1st 24 hrs. after shot _____

Gas _____ Cu. Ft.

Dry Hole _____

Abandoned _____

Date

JUL 28 1930

19

S. J. LEWIS Scout


Map No. KANSAS Sec. 22 Twp. 32 R. 37 W

Well No. 103 Canyon

Argus Gas Company

Contractor

SECTION PLAT

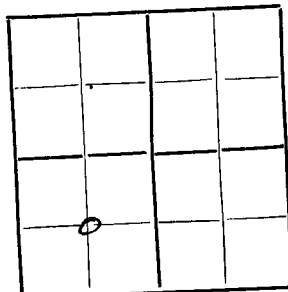

Ft. from N. Line

1320 Ft. from S. Line

Ft. from E. Line

1320 Ft. from W. Line

CONTINUED

Location

Rig up

Drilling and Remarks:

RECORD

Cased in., ft.

Sand 2035 2821

Gas 411

Oil

Total Depth 2821

PRODUCTION

1st 24 hrs. Nat.

1st 24 hrs. after shot

Gas Cu. Ft.

Dry Hole

Abandoned

Date

OCT 8 1930

192

J. LEWIS Scout