


Section 23 Township 33 Range 30W

Well No. #7 Langhoffer

Company Laneekan

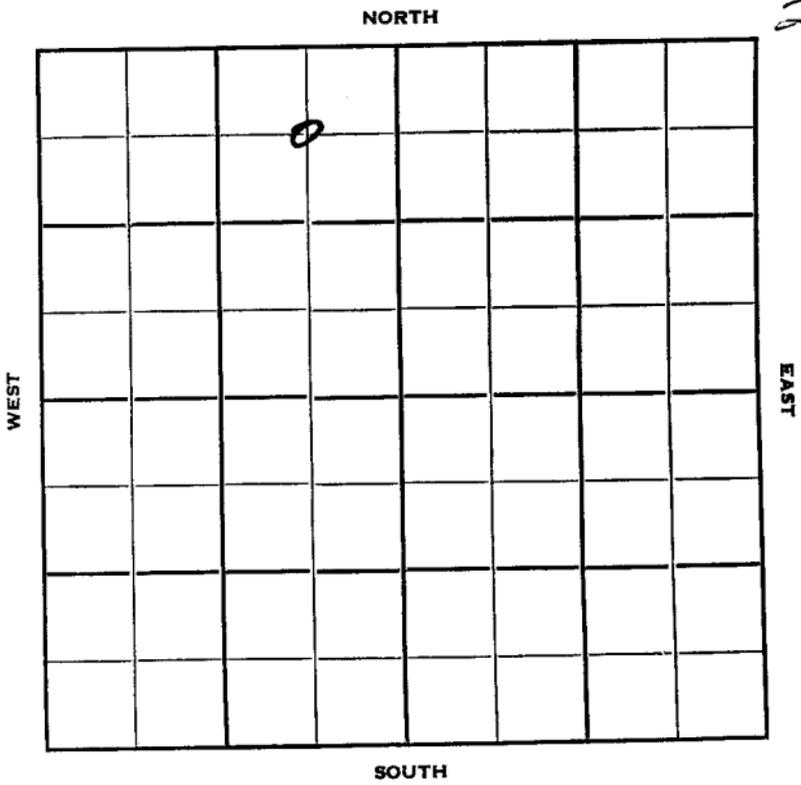

Sec. 23 Twp. 33 R. 30W

Well No. #7 Langhoffer Farm

Laneekan Company

Contractor


660' Ft. from N. Line

Ft. from S. Line

660' Ft. from E. Line

Ft. from W. Line

C NE NW

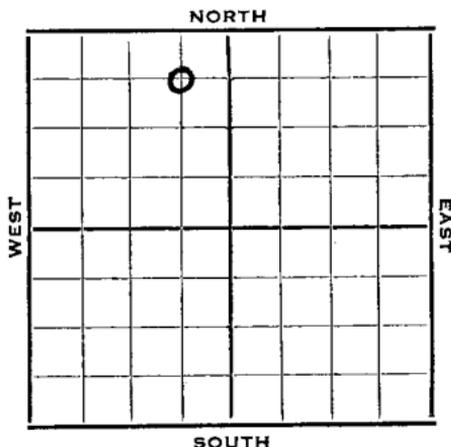

1952 Elev. 2717' REPORT

9/4	13" @ 667 Drlg. 2384
9/10	8" @ 2726 Drlg. 3260
9/17	Drlg. 4800'
9/24	DST 5247-76 1/2 hr. 30' M O# Drlg. 5490
10/1	Chester 5800'
10/8	TD 5832' 5" @ 5800'
10/15	"
10/22	36/5780-86 54/5765-74 F/36 1/2 BC 13 hrs.
10/29	NR
11/5	NR
11/12	"
11/20	"
11/27	"
12/4	"
12/11	NR
12/18	NR
12/25	NR
1/1	NR
1/8	NR
1/22	"

OVER

1953

1/28

Oil well TD 5832' 13" @ 667

8" @ 2726

DST 5247-76 open  $\frac{1}{2}$  hr. rec 30' mud O#

DST 5756-5800 open 40 min, gas in

3 min. F/oil in 29 min 1830#

Chester 5800' TD 5832' 5" @ 5800

36/5780-86 54/5765-74 F/36 $\frac{1}{2}$  BO

13 hr.

Schl. Tops: Ft. Riley 2870', Lans.

4440', Marm. 5194', Atoka 5476'

Morrow 5698', Chester 5759',

Comp. 150 BOPD

**COMPLETED**



