


KANSAS Stevens

Section 23 Township 33 Range 38W

Well No. 3 Coulter

Company Republic Nat. & Gas

Hugoton

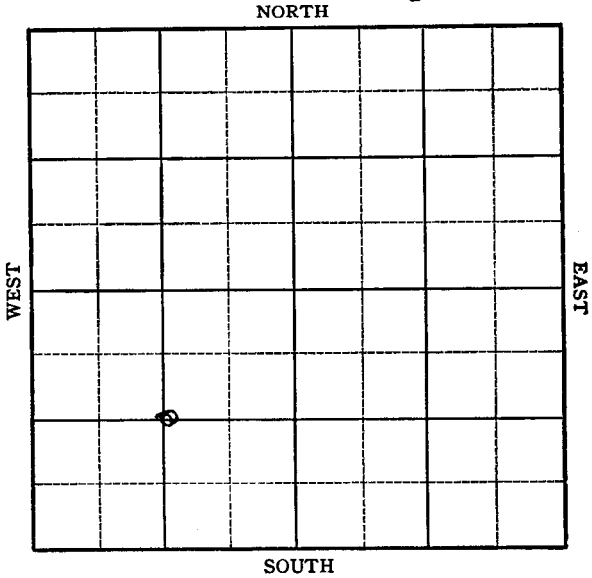

Stevens

Sec. 23 Twp. 33 R. 38^W ✓

Well No. #3 Coulter Farm

Republic Natural & Gas Company

(Moran, Cont.)

Hugoton

Pool


NORTH

1320' Ft. from N. Line

 Ft. from S. Line

1320' Ft. from E. Line

 Ft. from W. Line

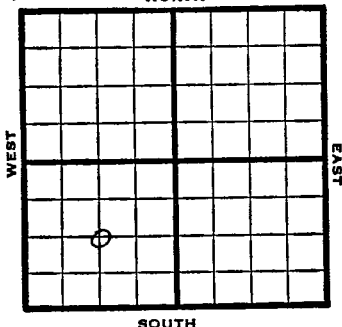

C SW

1949 Lev 3161' REPORT

8/3	RUR
8/10	10" @ 622'
	TD 2555'
	7" @ 2550'
8/17	Drlg. 2725'
8/24	TD 2741-208' of 5" Perf liner @ 2741
	16000 acid
8/31	TD 2741'
	7" @ 2550'
	208' of 5" Perf Liner @ 2741'
	21000 acid
	26,871,000 Gas
	379# R Pr.
	Comp
	COMPLETED

Map No. _____ Sec. 23 _____ Twp. 33 _____ R. 38W

Well No. 3 Coulter

Republic Natural & Gas Company

Moran

~~FIRST REPORT~~ Contractor

C SW


SECTION PLAT

1320 Ft. from N. Line

Ft. from S. Line

1320 Ft. from E. Line

Ft. from W. Line

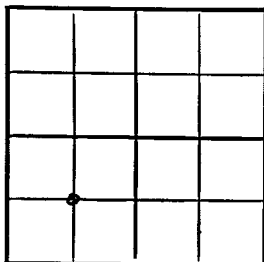

Stevens

RECORD

Location

Cased _____ in., _____ ft.

Rig up

Sand _____

Drilling and Remarks:

Gas _____

R U R

Oil _____

Total Depth _____

PRODUCTION

1st 24 hrs. Nat. _____

1st 24 hrs. after shot _____

Gas _____ Cu. Ft.

Dry Hole _____

Abandoned _____

Date

AUG 3 1917

19

S. J. LEWIS Scout

Well No. 3 Coulter

COMPLETE

C SW

Contractor

CONFIDENTIAL
E 1, 3/61

SECTION PLAT


1320 Ft. from N. Line

Ft. from S. Line

1320 Ft. from E. Line

Ft. from W. Line

Stevens County

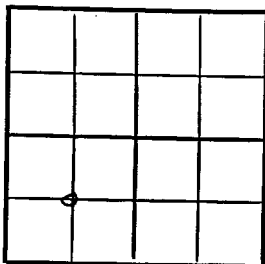

RECORD

Location_____

Rig up_____

Drilling and Remarks:

71102550

208745 "Original"

C 2741


26, 271, 000 ~~600~~


Cased _____ in _____ ft.

Sand_____

Gas _____

Oil_____

Total Depth 2741

PRODUCTION

1st 24 hrs. Nat. _____

1st 24 hrs. after shot_____

Gas _____ Cu. Ft.

Dry Hole_____

Abandoned_____

Date _____

AUG 31 1949

19

S. J. LEWIS

Scout