

Seward


FORM 51 10M 12-46 PETROL

KANSAS

Section 23 Township 33 Range 31W

Well No. 1 Chas. Wheatley

Company Stanolind

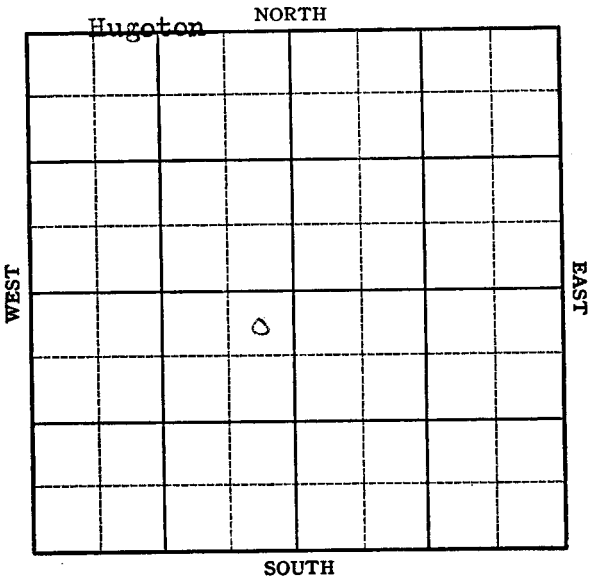

Seward

Sec. 23 KANSAS Twp. 33 R. 31 W

Well No. #1 Chas. Wheatley Farm

Stanolind Company


Hugoton

~~290~~ 330 Ft. from N. Line

_____ Ft. from S. Line

~~290~~ 330 Ft. from E. Line

_____ Ft. from W. Line

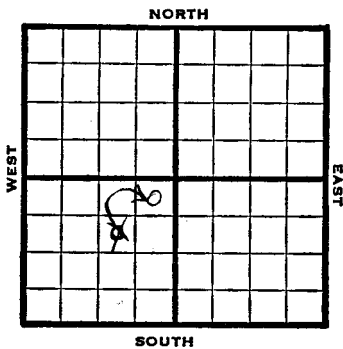

~~SW NE SW~~ NE-SW

947 E₁ 2749' REPORT

6/11 Location

6/17 13" @ 647' W00

6/24 Drlg. 2490'

7/1 9" @ 2486'
Drlg 3065'

7/8 Drlg. 4011'

7/16 Drlg 4335'

7/22 Drlg. 4723'
Lansing 4314

7/29 Drlg 5057'

8/6 Drlg 5495'

8/13 Mississippi 5402
Drlg. 5839'

8/20 Drlg 6013'

8/27 Drlg. 6108'

9/3 "

9/10 Drlg. 6363'

9/17 Drlg. 6456'

9/24 Drlg. 6636'

10/1 Misener 6842'
Drlg. 6852'

OVER

5692
5749
3853

2749
2852

5402
5839
6013
6108
6363
6456
6636
6842
6852

1948

3/31 Pump 6 oil / 2 W in 7 hrs.
18 shots 5915-18

4/7 "

4/14 "

4/21 Pump 139 bbls oil & 91 W
in 19 hrs,

4/28 "

5/5 "

5/12 "

5/19 "

5/26 "

6/1 "

6/9 "

6/16 "

6/23 TD 7340'
5"@ 5980'
PB Lans. 5095'
Pump 132 oil / 88 W pot
380 Gr.
Comp.

COMPLETED

Map No. 0 Sec. 23 Twp. 33 R. 31W

Well No. 1 Chas. Wheatley

Stanolind

CORRECTION

Company

Contractor

NE SW


SECTION PLAT

330 Ft. from N. Line

 Ft. from S. Line

330 Ft. from E. Line

 Ft. from W. Line

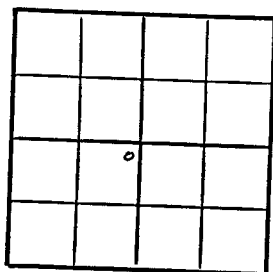

Seward County

Location

Rig up

Drilling and Remarks:

Reported

SW NE SW

RECORD

Cased in., ft.

Sand

Gas

Oil

Total Depth

PRODUCTION

1st 24 hrs. Nat.

1st 24 hrs. after shot

Gas

Cu. Ft.

Dry Hole

Abandoned

Date

JUN 25 1947

19

S. J. LEWIS

Scout

1947

10/8 Viola 6852'
Drlg. 7027'

10/15 Simpson 7060'
Arbuckle 7119'
Drlg. 7158'

10/22 TD 7284'

10/29 TD 7340'

11/5 PB 6032'
5" @ 5980'
WOC

11/12 Squeeze

11/19 "

11/25 "

12/3 "

12/10 "

12/17 100 shots 5865-90'
CO

12/30 2500 acid 5868-90'
CO

1948

1/7 PB 5756' @ 5868-90
160 shots. 5700-40' - 300' oil / W

1/14 Swb 18 bbls fluid trace oil squeeze

1/21 40 shots 5700-10
1500 acid, squeeze

1/26 "

2/4 "

2/11 Packers at 5860 & 5896' - 1000 acid
5865-85'

2/18 "

2/25 "

3/3 Pump 6 oil & 2 W in 7 hrs.
18 shots 5915-18'

3/10 "

3/17 "

3/24 "

Map No. _____ Sec. 23 Twp. 33 R. 31W

Well No. 1 Chas. Wheatley

Stanolind Company

FIRST REPORT

Contractor

SW NE SW


SECTION PLAT

990 Ft. from N. Line

_____ Ft. from S. Line

990 Ft. from E. Line

_____ Ft. from W. Line

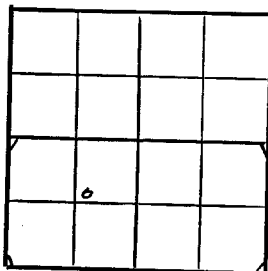

Seward County

Location X

Rig up _____

Drilling and Remarks:

RECORD

Cased _____ in., _____ ft.

Sand _____

Gas _____

Oil _____

Total Depth _____

PRODUCTION

1st 24 hrs. Nat. _____

1st 24 hrs. after shot _____

Gas _____ Cu. Ft.

Dry Hole _____

Abandoned _____

Date

JUN 11 1947

19

S. J. LEWIS

Scout

Map No. _____ Sec. 23 Twp. 33 R. 31W

Well No. 1 Chas. Wheatley

Stanolind

Company

COMPLETE

Contractor

HE ST

E 12749
SECTION PLAT

330 Ft. from N. Line

_____ Ft. from S. Line

330 Ft. from E. Line

_____ Ft. from W. Line

	6		

Seward County

Location _____

Rig up _____

Drilling and Remarks:

5" @ 5980

PS Lane 5095

Pump 132 oil + 88W
PS

3824

RECORD

Cased _____ in., _____ ft.

Sand _____

Gas _____

Oil ☒

Total Depth 7340

PRODUCTION

1st 24 hrs. Nat. _____

1st 24 hrs. after shot _____

Gas _____ Cu. Ft.

Dry Hole _____

Abandoned _____

Date

JUN 23 1948

S. J. LEWIS

Scout