

KANSAS


Seward

Section 23 Township 33 Range 34W

Well No. 1 Maxwell

Company Panhandle Eastern

Hugoton

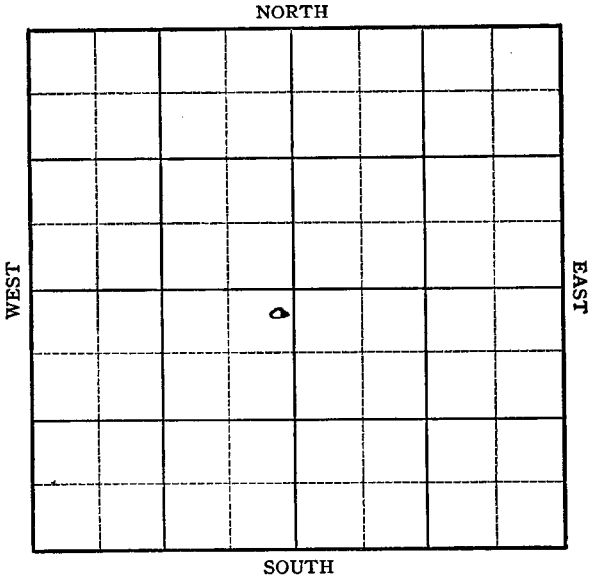

Seward
33

KANSAS

34W

Sec. 23 Twp. R.

Well No. #1 Maxwell Farm

Panhandle Eastern

Company

Jugoton (Moran, Cont.)


Pool

200' Ft. from N. Line

Ft. from S. Line

100' Ft. from E. Line

Ft. from W. Line

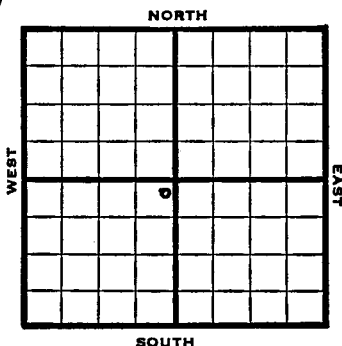

NE SW

1949 Elev 2885' REPORT

7/20 Location

7/27 "

8/3 10" @ 560'

Drlg. 1630'

8/10 TD 2605'

7" @ 2598'

8/17 "

8/24 TD 2750

179' of 5" Perf liner @ 2750

8/31 TD 2750'

7" @ 2598'

179' of 5" Perf Liner @ 2750'

1,220,000 Gas

439# R Pr.

Comp

COMPLETED

Kansas

Hugoton Pool

Map No. _____ Sec. 23 Twp. 33 R. 34WWell No. 1 Maxwell

Panhandle Eastern _____ Company

Moran _____ Contractor

NE SW

FIRST REPORT
SECTION PLAT200 Ft. from N. Line

_____ Ft. from S. Line

100 Ft. from E. Line

_____ Ft. from W. Line

	o		

Seward County

Location X

Rig up _____

Drilling and Remarks:

RECORD

Cased _____ in., _____ ft.

Sand _____

Gas _____

Oil _____

Total Depth _____

PRODUCTION

1st 24 hrs. Nat. _____

1st 24 hrs. after shot _____

Gas _____ Cu. Ft.

Dry Hole _____

Abandoned _____

Date

JUL 20 1949

19

S. J. LEWIS

Scout

Map No. Sec. 23 Twp. 33 R. 34W

Well No. 1 Maxwell

Panhandle Eastern

Company

COMPLETE

Contractor

NE SW

E1, 2885

SECTION PLAT

200

Ft. from N. Line

Ft. from S. Line

100

Ft. from E. Line

Ft. from W. Line

	4		

Seward County

Location

Rig up

Drilling and Remarks:

2' C2598

179' of 1" Pipe line

C2250

1,220,000 Cu

435' R/P

RECORD

Cased in., ft.

Sand

Gas

Oil

Total Depth 2750

PRODUCTION

1st 24 hrs. Nat.

1st 24 hrs. after shot

Gas Cu. Ft.

Dry Hole

Abandoned

Date

AUG 31 1949

19

S. J. LEWIS

Scout