

Section 14 Township 33 Range 24W

Well No. #1 Gardner

Company G M R Drlg. & Newmont

NORTH

|  |  |  |  |  |  |  |   |
|--|--|--|--|--|--|--|---|
|  |  |  |  |  |  |  | 0 |
|  |  |  |  |  |  |  |   |
|  |  |  |  |  |  |  |   |
WEST

EAST

SOUTH

Clark

KANSAS



Sec. 14 Twp. 33 R. 24 W

Well No. # 1 Gardner Farm

G-M-R Drlg. & Newmont Company

Contractor

Wildcat

330 Ft. from N. Line


\_\_\_\_\_ Ft. from S. Line

330 Ft. from E. Line

\_\_\_\_\_ Ft. from W. Line

NE NE NE

Stanolind - F.O.

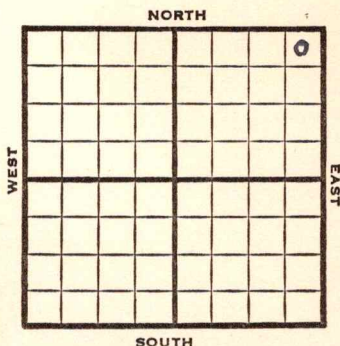

1952

Elev. 2045

REPORT

8/6

Spud 8-3-52  
10" @ 602  
Drlg. 1230'

8/20

Lans. 4429 Shut down 4728

8/27

Marm. 4800' Shut down 5323'

9/4

Spud 8-3-52  
D&A TD 5535  
10" @ 602

Lans. 4429 Marm. 4800

DST 5353-68 opn 1 hr. Rec. 5' mud

Miss 5330

TD 5535 D&A

ABANDONED

J. G. McGEHEE

AUG 8 1952

Scout Cards *mm*  
Land Small Map  
Land Wall Map  
Tracings  
France Map  
Pierce Map  
Misc.

Orig. Data

J. G. McGEHEE

SEP 10 1962

|                |    |
|----------------|----|
| Scout Cards    | OK |
| Land Small Map |    |
| Land Wall Map  |    |
| Tracings       |    |
| France Map     |    |
| Pierce Map     |    |
| Misc.          |    |