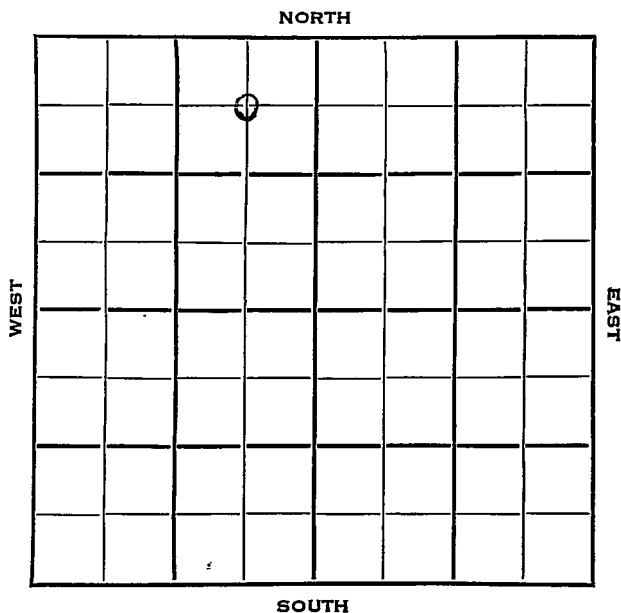


Section 24 Township 33 Range 42 WWell No. # 1 Minor "A"Company Cities Service

Morton

KANSAS

SEC.	TWP.	R.
24	33	42 W ✓

WELL NO.

1 Minor "A"

FARM

COMPANY

Cities Service

CONTRACTOR

Greenwood Pool


660 Ft. from N. Line

Ft. from S. Line

660 Ft. from E. Line

Ft. from W. Line

C NE NW

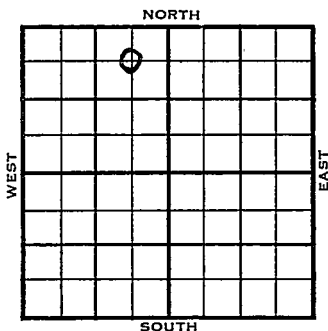

1953

ELEVATION

3468'

REPORT

10/21

Spud 10-14-53

8" @ 600

Drlg. 2340'

10/28

Spud 10-14-53 D & A TD 3550'


8" @ 600 Top. 3107 Lans 3391

TD 3550'

D & A

ABANDONED

$$\begin{array}{r}
 3468 \\
 3107 \\
 \hline
 + 361 \\
 \hline
 \end{array}
 \qquad
 \begin{array}{r}
 3468 \\
 3391 \\
 \hline
 + 77 \\
 \hline
 \end{array}$$

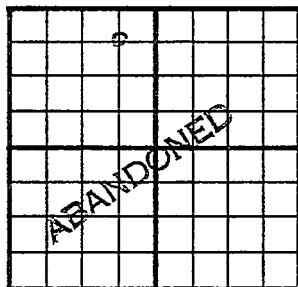County Morton State KansasSec. 24 (Blk.) 33 (Sur.) 42W Map No.Operator Cities ServiceWell No. 1 Farm Minor "A"Elev. 3468 Location C NE NW660 Ft. From N Line NW660 Ft. From E Line Quarter1st. ReportCompletion OCT 28 1953Remarks Greenwood PoolSpudding Date 10-14-53Drlg. Data D & A TD 35508" @ 600 Top. 3107 Lans. 3391TD 3550D & A

J. G. McGEHEE

Sec. 24 (Blk. Twp.) 33 (Sur. Rge.) 42W Map No.

Well No. 1 Farm Minor "A"

Elev.	Location	C N E M
-------	----------	---------

6

FIRST REPORT

660 Ft. From E Line Quarter

1st. Report OCT 21 1953

Completion

Remarks

Spudding Date **10-14-53**

Drig. Data Greenwood Pool

8" @ 600 drlg. 2340