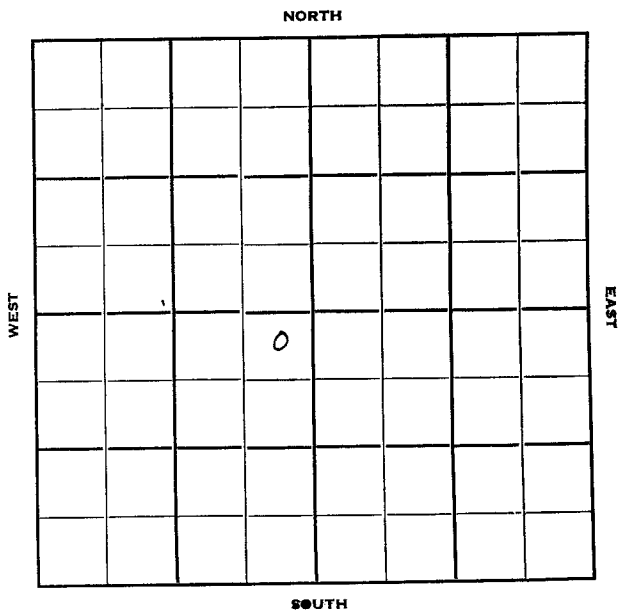


Section 24 Township 33 Range 34-WWell No. #1 BlairCompany Cabot Carbon

74 018713

Seward

Sec. 24 Twp. 33 R. 34-W ✓

Well No. #1 Blair Farm

Cabot Carbon

Company

Higoton

Contractor

330

Ft. from N. Line


Ft. from S. Line

330

Ft. from E. Line

Ft. from W. Line

NE NE SW

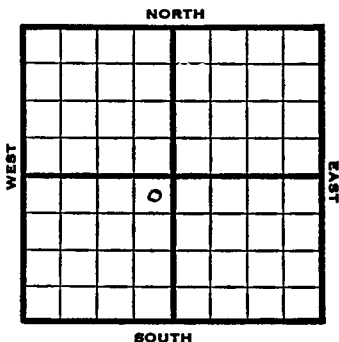

1951

Elev. 2883' REPORT

1/3

Location

3/14

Spud 12-22-50

Gas well TD 2690'


10" @ 556, 7" @ 2614, TD 2690'

Her. 2605, Krider 2636,

21,000 A

Comp. 13,024,000 gas 429#

COMPLETED

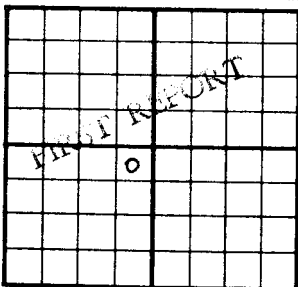County **Seward** State **Kansas**Sec. **24** (Blk.) **33** (Sur.) **34W** Map No.Operator **Cabot Carbon**Well No. **1** Farm **Blair**Elev. Location **NE NE SW****330** Ft. From **N** Line **SW****330** Ft. From **E** Line Quarter1st. Report **JAN 3 1951**


Completion

Remarks

Spudding Date

Drig. Data **Hugoton Pool****Location**

TYRA

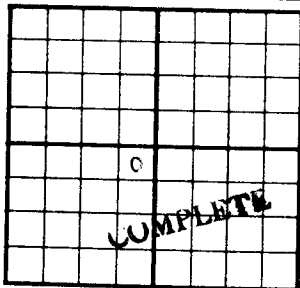County Seward State KansasSec. 24 (^{Bik.}_{Twp.}) 33 (^{Sur.}_{Rge}) 34W Map No.Operator Cabot CarbonWell No. 1 Farm BlairElev. 2883 Location NE NE SW330 Ft. From N Line SW330 Ft. From E Line Quarter1st. ReportCompletion MAR 14 1951Remarks Hugoton PoolSpudding Date 12-22-50Drlg. Data Gas well TD 269010" @ 556 7" @ 2614 TD 2690Her. 2605 Krider 2636 21000 AComp. 13,024,000 gas 429#

J. E. TYRA