

Section 25 Township 33 Range 43 WWell No. # 1 Miller "S"Company Cities Service et al

NORTH

			0				

WEST

EAST

SOUTH

Morton

KANSAS ✓

Sec. 25 Twp. 33 R. 43 WWell No. # 1 Miller "S" FarmCities Service et al CompanyHolm Drlg. Contractor


Greenwood Gas Pool

Ft. from N. Line

330 Ft. from S. Line330 Ft. from E. Line

Ft. from W. Line

SE SE NW

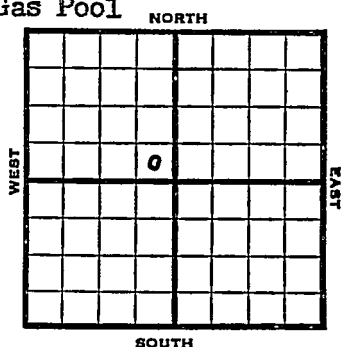

1953

Elev. 3584' REPORT

6/24

8" @ 600
Drlg. 1655'

7/1

Drlg.

7/22

N.R.

8/19

N.R.

9/2

Gas Well

TD 3248'

8" @ 600'

Top. 2886', Lans 3134,

TD 3248'

5" @ 3247'

CO to 3214'

10/ 3184-86 20/ 3176-80 1000 A

734,000 gas $4\frac{1}{2}$ qt wtr. per min

CO to 3175 20/ 3162-66 20/ 2154-58

70/ 3134-48 2000 A $2\frac{1}{2}$ mcf/g 3 qt wtr

CO to 3148 30/ 3134-40 2000 A

1,230,000 gas SP 3100 130/ 3006-82

4000 A 11,200,000 gas 6000 A

CO to 3148


9,860,000 gas SP 2992

195/ 2917-96 5000 A 6,400,000 gas

6000 A 6000 A Comp. $22\frac{1}{2}$ mcf/gpd

431#

COMPLETED

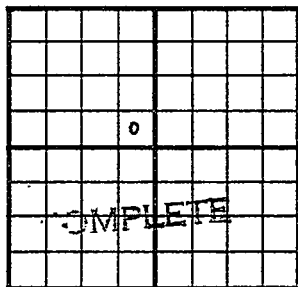County Morton State KansasSec. 25 (Blk.
Twp.) 33 (Sur.
Rgs.) 43W Map No.Operator Cities ServiceWell No. 1 Farm Miller "S"Elev. 3584 Location SE SE NW330 Ft. From S Line NW330 Ft. From E Line Quarter1st. ReportCompletion SEP 2 1953Remarks Greenwood GasHolm drlg. - Contr.Spudding DateDrlg. Data Gas well TD 32488" @ 600 Top. 2886 Lans. 3134TD 3248 5" @ 3247 CO to 321410/ 3184-86 20/ 3176-80 1000 A734,000 gas $4\frac{1}{2}$ qt. wtr. per min.CO to 3175 20/ 3162-66 20/ 3154-5870/ 3134-48 2000 A $2\frac{1}{2}$ mcfg 3 qt wtr.CO to 3148 30/ 3134-40 2000 A1,230,000 gas SP 3100 130. 3006-824000 A 11,200,000 gas 6000 ACO to 3148 9,860,000 gas SP 2992195/ 2917-96 5000 A 6,400,000 gas6000 A 6000 A Comp. $22\frac{1}{2}$ mcfgpd 431#

J. G. McGEHEE

County **Morton** State **Kansas**

Sec. **25** (Blk. **33** (Sur. **43W** Map No.

Operator **Cities Service et al.**

Well No. **1** Farm **Miller "S"**

Elev.	Location	SE SE NW
-------	----------	----------

0

FIRST REPORT

330 Ft. From S Line NW

330 Ft. From E Line Quarter

1st. Report ~~24~~ 24 1953

Completion

Remarks

Holm D. Ig. - Contr.

Spudding Date

Drilg. Data Greenwood Gas Pool

8" @ 600 drlg. 1655