


1st 24 hrs. Nat. _____
 1st 24 hrs. after shot _____
 Gas _____ cu. ft. _____
 Dry Hole _____
 Abandoned _____

1320 Ft. from W. Line

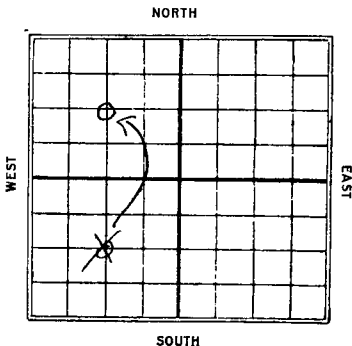

REPORT

REPORT

4/9	Reg	
4/16	Herbq.	530'
4/23	"	1252'
5/30	"	1370'
5/7	8"	2585'
5/21	Pust	2585'
5/21	Herbq.	2712'
5/28	Land	2626-2890
		TD 2890
		5 1/2 M gas
		comp.


Map No. 1849 Sec. 25 Twp. 29 R. 22 W

Well No. 1 Bride

Argus Gas Company

Contractor

SECTION PLAT

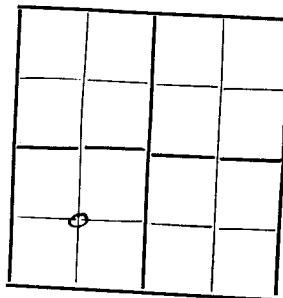

Ft. from N. Line

1820 Ft. from S. Line

Ft. from E. Line

1820 Ft. from W. Line

Location

Rig up

Drilling and Remarks:

Rig

RECORD

Cased _____ in., _____ ft.

Sand _____

Gas _____

Oil _____

Total Depth _____

PRODUCTION

1st 24 hrs. Nat. _____

1st 24 hrs. after shot _____

Gas _____ Cu. Ft.

Dry Hole _____

Abandoned _____

Date

_____ 192_____ S. J. LEWIS Scout

Map No. KANSAS Sec. 25 Twp. 33 R. 27 W

Well No. 1 Pride

Argus Gas Company

Contractor


SECTION PLAT

1320 Ft. from N. Line

..... Ft. from S. Line

..... Ft. from E. Line

1320 Ft. from W. Line

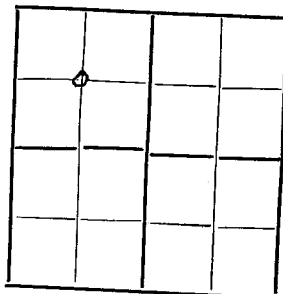

CORRECTION

Location

Rig up

Drilling and Remarks:

Reported
C. B. H.

RECORD

Cased in., ft.

Sand

Gas

Oil

Total Depth

PRODUCTION

1st 24 hrs. Nat.

1st 24 hrs. after shot

Gas Cu. Ft.

Dry Hole

Abandoned

Date

APR 16 1930

..... 192

S. J. LEWIS Scout

Map No. **KANSAS** Sec. 25 Twp. 13 R. 27WWell No. 1 Prairie

Company

Contractor

SECTION PLAT


1340 Ft. from N. Line

..... Ft. from S. Line

..... Ft. from E. Line

1320 Ft. from W. Line

COMPLETED

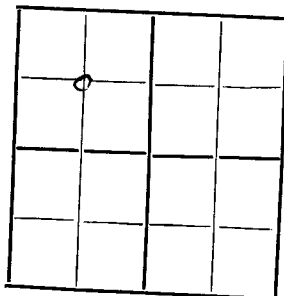

RECORD

Location.....

Cased..... in., ft.

Rig up.....

Sand 2626 - 2880

Drilling and Remarks:

Gas.....

Oil.....

Total Depth 2890

PRODUCTION

1st 24 hrs. Nat.....

1st 24 hrs. after shot.....

Gas..... Cu. Ft.

Dry Hole.....

Abandoned.....

Date

MAY 28 1930

192...

S. J. LEWIS Scout