


Section 25 Township 33 Range 35W

Well No. 1-25 Myrick

Company P. E. P. L.

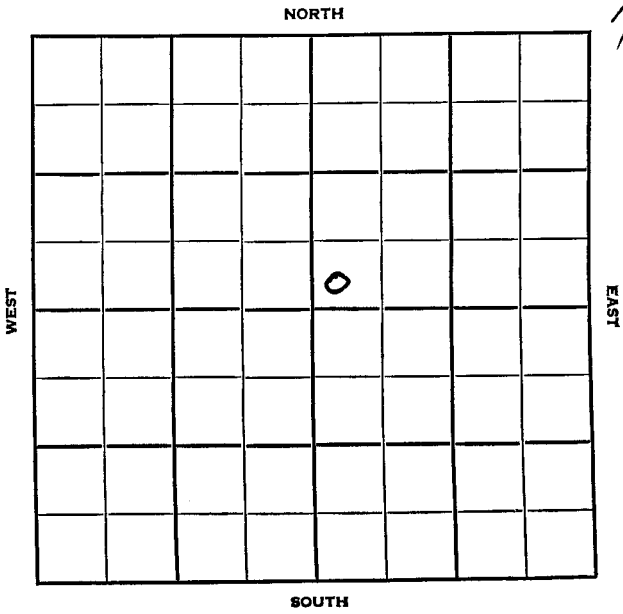

Stevens KANSAS

SEC.	TWP.	R.
25	33	35W

WELL NO.

1-25 Myrick

COMPANY

FARM

P. E. P. L.

CONTRACTOR

Kuhn Bros.


Hugoton Pool

2440 Ft. from N. Line

Ft. from S. Line

2440 Ft. from E. Line

Ft. from W. Line

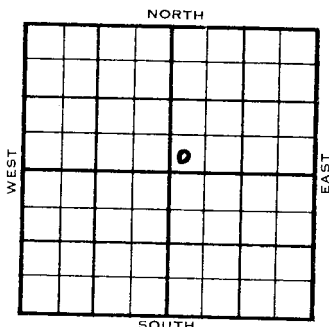

SW SW NE

	ELEVATION	REPORT
1954	2965'	

9/22

Spud 9-18-54
10" @ 674' w/275 sks, WOC

11/3

Spud 9-18-54 - Gas Well
TD 2823'
10" @ 674'
Hol. 2582', Her. 2645', Kri 2657',
Win 2757', Ft. Riley 2809'
TD 2660'
7" @ 2654'
DD 2823', 1,466,000 cf
PB 2802'
10,000A
6,397,000 cfg, 13000A
Comp. 2,093,000 cfgpd 381.8#

COMPLETED

County **Stevens** State **Kansas**

Sec. **25** (Blk. Twp.) **33** (Sur. Rge.) **36W** Map No. _____

Operator P. E. P. L.

Well No. **1-25** Farm **Myrick**

Elev.	Location	SW	SW	NE
-------	----------	----	----	----

FIRST REPORT

2440 Ft. From N Line NE

2440 Ft. From E Line Quarter

1st. Report SEP 22 1954

Completion

Remarks

Kuhn Bros. Tools

Spudding Date 9/18/54

Drig. Data Hugoton Pool

10" @ 674 w/275. WOC

FABEN GILSTRAP

County Stevens State Kansas

Sec. 25 (Blk. Twp.) 33 (Sur. Rge.) 35W Map No.

Operator P.E.P.L.

Well No. 1 Farm Myrick

Elev.	2965	Location	SW SW NE
-------	------	----------	----------

COMPLETE

2440 Ft. From N Line NE

2440 Ft. From E Line Quarter

1st. Report

Completion NOV 3 1954

Remarks	Hugoton Pool
---------	--------------

Kuhn Bros - Contr.

Spudding Date 9-18-54

Drig. Data Gas well TD 2823

10" 674 Hol. 2582 Her. 2645

Kri. 2657 Win. 2757 Ft. Riley 2809

TD 2660 7" @ 2654 DD 2823 1,466,000 c

PB 2802 10,000 A 6,397,000 cfg 13000A

Comp. 2,093,000 cftgd 381.8%

FABEN GILSTED