DX 78-1


KANSAS

Seward

Section 25 Township 33 Range 33 W

Well No. # 1 Bush

Company ~~Panhandle Eastern~~

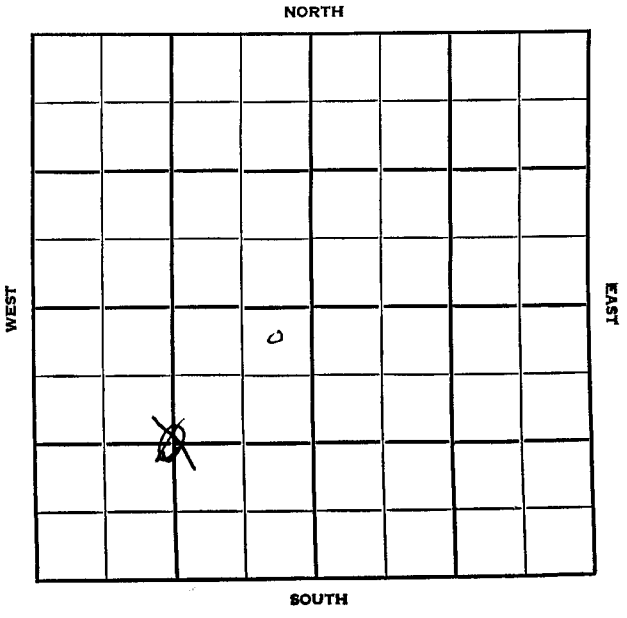

Seward.

SEC.	TWP.	R.
25	33	33W

WELL NO. #1 Bush FARM

COMPANY Panhandle Eastern

CONTRACTOR

Hugoton Pool


330 Ft. from N. Line

~~1320~~ Ft. from S. Line

330 Ft. from E. Line

~~1320~~ Ft. from W. Line

NE NE SW
~~C SW/4~~

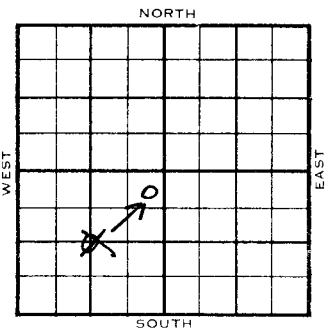

1954	ELEVATION 2808'	REPORT
12/15	Spud 12-12-54 10" @ 592' WOC.	
1955 2/23	Spud 12-12-54 Gas well TD 2703 10" @ 592 TD 2620 7" @ 2610 DD 2703 11,000 A Hol. 2538 Her. 2595' Kri. 2630 16,000 A Comp. 538,000 CFGPD 387# COMPLETED	

DX-78

FORM 275 FOR SALE BY KANSAS BLUE PRINT CO.


County Seward State Kansas

Sec. 25 (Blk. Twp.) 33 (Sur. Rge.) 33W Map No.

Operator Panhandle Eastern

Well No. 1 Farm Bush

Elev. Location C SW/4

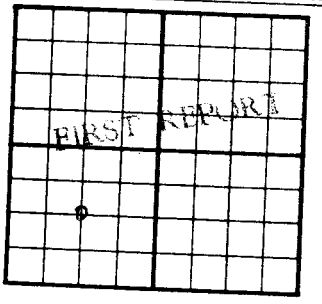

1320 Ft. From S Line SW

1320 Ft. From W Line Quarter

1st. Report DEC 15 1954

Completion

Remarks

Spudding Date 12-12-54

Drlg. Data Hugoton Pool

10" @ 592 WOC

FORM 26 200 BKS, 4-52 PETROL

Kansas

Map No. _____ Sec. 25 Twp. 33 R. 33W


Well No. 1 Bush

Panhandle Eastern Company

CORRECTION Contractor

NE NE SW

SECTION PLAT

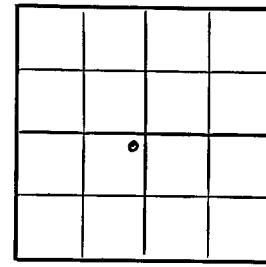

330 Ft. from N. Line

_____ Ft. from S. Line

330 Ft. from E. Line

_____ Ft. from W. Line

Seward County

Location _____

Rig up _____

Drilling and Remarks:

Reported
c SW/4

RECORD

Cased _____ in., _____ ft.

Sand _____

Gas _____

Oil _____

Total Depth _____

PRODUCTION

1st 24 hrs. Nat. _____

1st 24 hrs. after shot _____

Gas _____ Cu. Ft.

Dry Hole _____

Abandoned _____

Date

DEC 22 1954

_____ 19____

_____ Scout

FORM 275 FOR SALE BY KANSAS BLUE PRINT CO


County Seward State Kansas

Sec. 25 (Blk. Twp.) 33 (Sur. Rge.) 33W Map No.

Operator Panhandle Eastern

Well No. 1 Farm Bush

Elev. 2808 Location NW NE SW

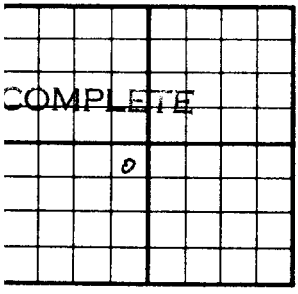

330 Ft. From N Line SW

330 Ft. From E Line Quarter

1st. Report

Completion FEB 2 3 1955

Remarks Hugoton Pool

Spudding Date 12-12-54

Drlg. Data Gas well TD 2703

10" @ 592 TD 2620 7" @ 2610

DD 2703 11000 A Hol. 2538

Her. 2595 Wri. 2630 16000 A

Comp. 538,000 cfgpd 387#

FABEN GILSTRAP