


Section 19 Township 33 Range 26W

Well No. #2 Horner

Company Deep Rock

NORTH

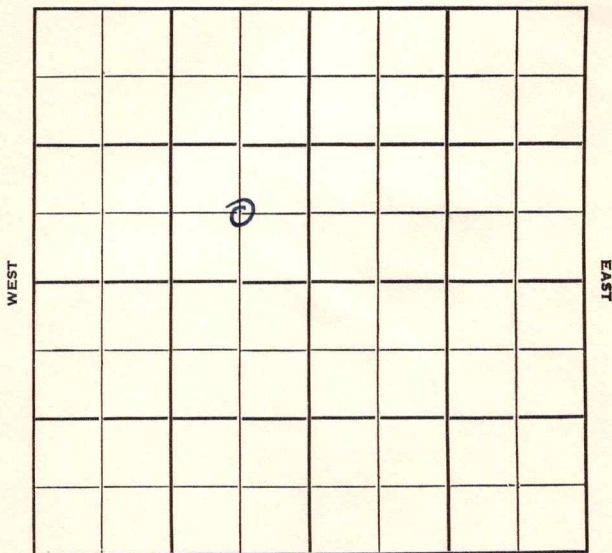

SOUTH

Meade

KANSAS

Sec. 19 Twp. 33 R. 26 W

Well No. # 2 Horner Farm

Deep Rock Company

Contractor


Ft. from N. Line

660 Ft. from S. Line

560 Ft. from E. Line

Ft. from W. Line

C SE NW

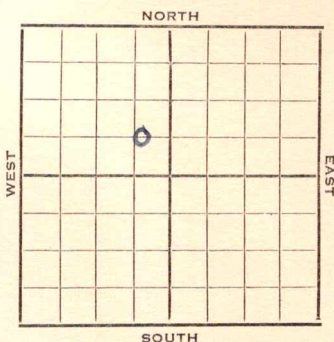

1952 Elev. 2325 REPORT

8/6 Spud 8-4-52
13" @ 415 WOC

8/20 Fishing @ 3639

8/27 Drlg. 4730'

9/3 Lans. 4581
Drlg. 5390

9/10 Morrow Sh 5669 Chester 5712
DST 5731-42 1 hr. gas 2010#
Drlg. 5760

9/17 F 5742-76, 32' DST 5760-76, 1/2 hr.
5'm NS TD 5825
DST 5774-5825, 1/2 hr. 70'm Sch.
7" @ 5816' CO 5810 96/ 5732-48
72/ 5732-46

9/24 Spud 8-4-52 Gas Well TD 5825
13" @ 415 Lans. 4581
Morrow sh 5669 Chester 5712
DST 5731-42 opn 1 hr. gas 2010#
DST 5760-76 opn 1/2 hr.
Rec. 5' mud 0# TD 5825
DST 5774-5825 opn 1/2 hr. Rec. 70'
mud 0# 7" @ 5816 CO to 5810
96/5732-48 72/5732-46 2000 A
Comp. shut in gas well 8,426,000


COMPLETED

County **Meade** State **Kansas**
 Sec. **19** (Blk. **33**) (Sur. **2** Rge. **6W**) Map No.

Operator **Deep Rock**

Well No. **2** Farm **Horner**

Elev. Location **C SE NW**

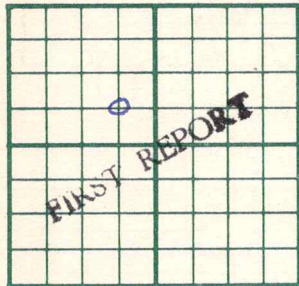

660 Ft. From **S** Line **NW**
560 Ft. From **E** Line Quarter

1st. Report **AUG 6 1952**

Completion


Remarks

Spudding Date **8-4-52**

Drlg. Data

13" @ 415 WOC

J. G. MCGHEE

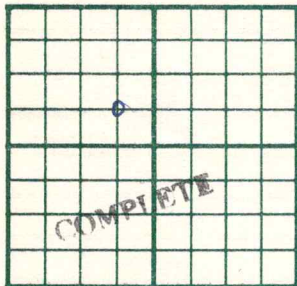County Meade State KansasSec. 19 (Blk. 33 Twp.) (Sur. 26W Rge.) Map No.Operator Deep RockWell No. 2 Farm HornerElev. 2325 Location C SE NW660 Ft. From S Line NW560 Ft. From E Line Quarter

1st. Report

Completion SEP 24 1952

Remarks

Spudding Date 8-4-52Drlg. Data Gas well TD 582513" @ 415 Lans. 4581 Morrow sh. 5669Chester 5712 DST 5731-42 open 1 hr.gas 2010# DST 5760-76 open $\frac{1}{2}$ hr.Rec. 5' mud 0# TD 5825 DST 5774-5825open $\frac{1}{2}$ hr. Rec. 70' mud 0# 7" @ 5816CO to 5810 96/ 5732-48 72/ 5732-462000 A Comp. shut in gas well 8,426,000