


Section 20 Township 33 Range 26 W

Well No. # 2 Hörner

Company Gulf Coast Rice Farms Inc.

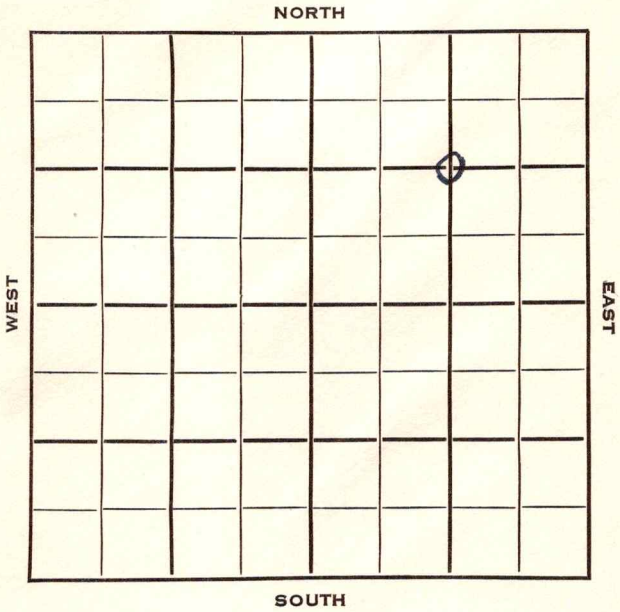

Meade

KANSAS ✓

Sec. 20 Twp. 33 R. 26W

Well No. #2 Herner Farm

Gulf Coast Rice Farms, Inc. Company

D & M Drlg. Contractor


McKinney Gas Pool

1320 Ft. from N. Line

_____ Ft. from S. Line

1320 Ft. from E. Line

_____ Ft. from W. Line

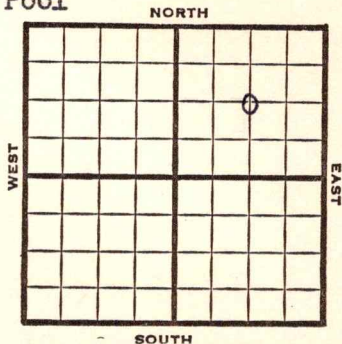

C NE/4

1953 **Elev. 2262'** REPORT

4/29 Spud 4-19-53
9" @ 601
Drlg. 2933'

5/7 Drlg. 4152'

5/21 **Chester 5632**

DST 5659-84 1½ hrs., gas in 13" 100,000
gas, 195' gcm 1720# 20"
Drlg 5703'

5/28 CO 5850'

6/24 NR

7/1 "

9/9 "

9/30 Spud 4-19-53

Gas Well

TD 5967'

9" @ 601'

Chester 5632,

DST 5659-84 opn 1½ hr, gas in 12min
rec 100,000 gas 195' gcm, 1720#

DST 5690-5743' opn 3/4 hr, rec 55'
sgcm, 450#

DST 5746'-5829' opn 35 min, rec 92' mud
890#.

OVER

1953

Information brought forward.

9/30 DST 5829'-79' opn $\frac{1}{2}$ hr, rec 565' mud
TD 5967'
5" @ 5835'
PB 5815'
8/ 5779-81 16/ 5783-87 18/ 5779-85
SP 5749
1000 A 3000 A 24/ 5680-86
28/ 5672-76 Morrow sh 5605 9000 A
Top. 3550, Heeb 4318, Lans 4510,
Ehester 5640, St. Gen. 5925 3000 A
Comp. 730,000 gas

COMPLETED

