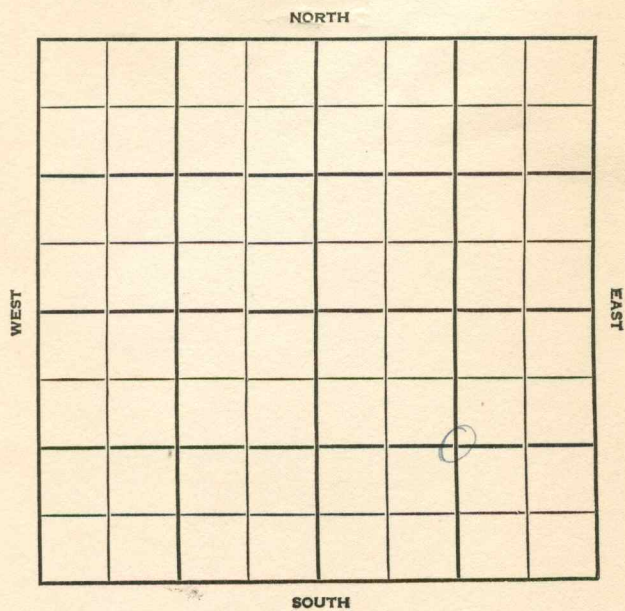


Section 34 Township 33 Range 26WWell No. #1 McKinney Gas UnitCompany Atlantic-Skelly ($\frac{1}{4}$)

FORM 513 SUNRAY

County Meade Elev. _____
 Sec. 34 Twp. 33 Rge. 26W
 Company Atlantic-Skelly ($\frac{1}{4}$)
 Farm Name McKinney Gas Unit No. 1

TOPS	DEPTH	LOG	DATUM	Loc. in Sec.
Anh.				C SE/4
TP.				
H.				
Tr.				
Dg.				
Bl.				
L.				Geol.
K.C.				Contr.
B.K.C.				
Ce.				
C.				
M.				Pool
M.				McKinney
Mz.				
Mo.				
V.				
S.				
S.				
A.				
R.				
Pe.				
G.				
T.D.				

Date Comm.

Location

35

FORM 513 SUNRAY

County Meade Elev. 2267
 Sec. 34 Twp. 33 Rge. 26W
 Company Atlantic-Skelly (L)
 Farm Name McKinney Gas Unit No. 1

TOPS	DEPTH	LOG	DATUM	Loc. in Sec.
Anh.				C SE/4
Tr.				
H.		4368		
Tr.				
Dg.				
BL				
L.		4550		
K.C. <u>MW</u>		5677		Geol.
B.K.C.				
Ce.				Contr.
C.				
M. <u>chest</u>	5697	5679	-3412	
M.				Pool
K.				McKinney
Mz.				
Me.				
V.				
S.				
S.				
A.				
R.				
PE.				
G.				
TD	5900			

COMPLETE

JUN 26 '57

Date Comm.

Location DEC 12 '56 12-117.56 ID 199.
 DEC 19 '56 7578 1199/500 ID 2993
 026 '56 ID 5011 JAN 2 '57 DST 5687
 -5766 PKY Failed DST 5683-5771
 1hr 6/3" stabil @ 1 MILE FEG
 JAN 9 '57 ga 734 MCF in 1/3" run
 50' GCM BHP 1730/20 DST
 5775-5831 ga 1hr 15' Md FP
 155-140 BHP 220/30 DST

FORM 513-1 SUNRAY

5801-5900 ga 45" ml 60' Md
 FP 50-60 BHP 550/30 9/12
 @ 5900/200 JAN 10 '57 58/5741-58
 55G FRAC 10 X 10 ga 192 MCF
 16/64" ch TP 1000 CP 1460#
 JAN 23 '57 stabil ga 3,600 MCF
 FLd 1/2" ch TP 600# CP 940#
 JAN 30 '57 FEB 6 '57 ga 3,600 MCF
 FLd FEB 13 '57 ✓ FEB 20 '57 FEB 27 '57 MAR 6 '57
 MAR 13 '57 MAR 20 '57 MAR 27 '57 APR 3 '57 ✓ APR 10 '57
 APR 17 '57 APR 24 '57 MAY 1 '57 ✓ MAY 8 '57 MAY 15 '57
 MAY 22 '57 MAY 29 '57 JUN 5 '57 JUN 12 '57 JUN 19 '57 JUN 26 '57
 ga 3,600 MCF 1/4" ch
 TP 600# SITP 1500#
 SICP 1450#

34-33-26

C 2247