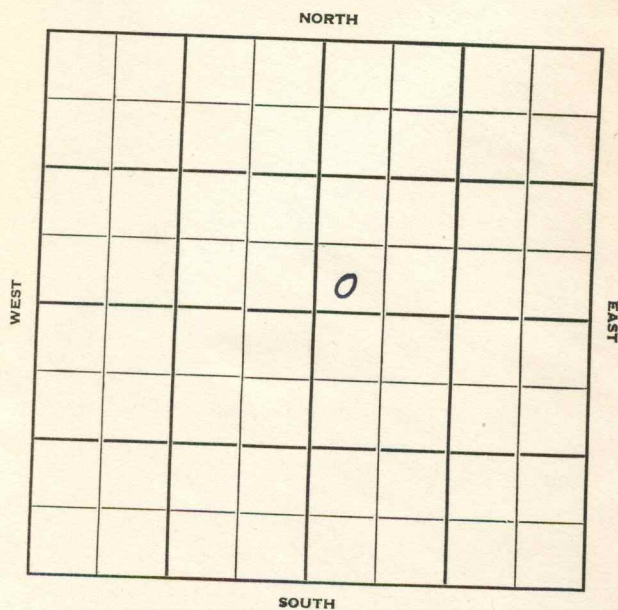


Meade

KANSAS

Section 28 Township 33 Range 26WWell No. #1 SheetzCompany Skelly

Meade

KANSAS

Sec. 28 Twp. 33 R. 26 WWell No. # 1 Sheetz

Farm

Skelly

Company

Contractor


Ft. from N. Line

330 Ft. from S. Line

Ft. from E. Line

330 Ft. from W. Line

SW SW NE

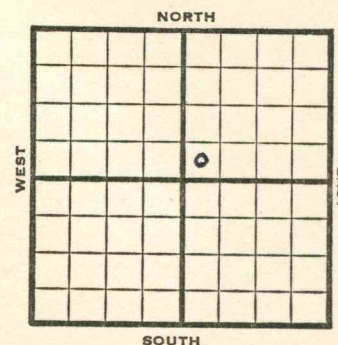

1952

Elev. 2340'

REPORT

8/13

Spud 8-8-52
Shut down 1375'

8/20

Drlg. 2966

8/27

Fishing @ 3343'

9/3

Drlg. 4147

9/10

Lans. 4605 Drlg. 4760

9/17

Marm. 5256'

Drlg. 5361'

9/24

Cherokee 5430 Marrow sh 5712

10/1

DST 5706-52, 1/2 hr. 35' M

DST 5064-5811, 1 hr.

685,000 gas

DST 5810-80 RTD 1 hr. 20' M

5" @ 5880'

10/8

Morrow sd 5721

102/5778-95 1000 A F/ 4,900,000 gas

Miss. 5737 10,000 A 8,770,000 gas

10/15

102/5778-95, 1000A 4,900,000 gas

Morrow Sd 5721, Miss 5737'

10/22

Spud 8-8-52 Gas well TD 5880'

9" @ 1375 Lans. 4605' Marm. 5256'

Cherokee 5430' Morrow sh. 5712'

DST 5706-52 open 1/2 hr. rec 35' mud

DST 5764-5811 open 1 hr, gas in 6 min

685,000 gas.

OVER

1952
10/22

(Information continued)

DST 5810-80 open 1 hr. rec 20' mud

Morrow sd 5721' 5" @ 5880'

102/5778-95 1000 A F/4,900,000 gas

Miss 5737' 10,000 A 8,770,000 gas.

Schlumberger Tops: Anhy 1300',

Well. 1952', Hol. 2556', Her 2581',

Kri 2652', Win. 2678' Tow. 2743'

Ft. Riley 2800' Heeb 4440',

Tor. 4452' Lans. 4680' Marm 5264'

Cherokee 5438', Morrow sh. 5708'

Morrow sd 5718' Chester 5734'

Comp. 8,770,000 gas

COMPLETED

J. G. McGEHEE

Drig. Data

Morrow sd. 5718

Chester 5734

Comp. 8,770,000

OCT 29 1962

