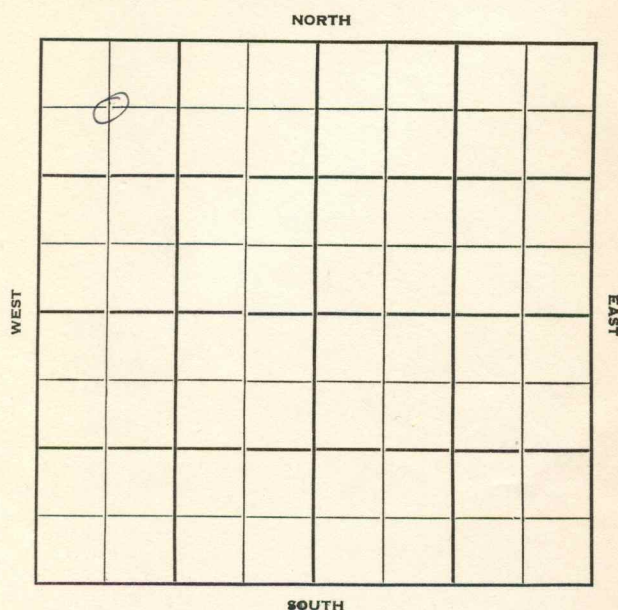


Meade

KANSAS

Section 29 Township 33 Range 26WWell No. #1 HornerCompany Deep Rock

Meade

KANSAS

Sec. 29 Twp. 33 R. 26WWell No. #1 Horner Farm

Deep Rock

Company

Rine Drlg. - Contr.


Contractor

Wildcat

660' Ft. from N. Line

Ft. from S. Line

Ft. from E. Line

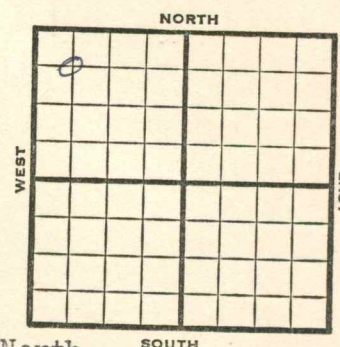660' Ft. from W. LineC NW NW
MCPC has Acre $2\frac{1}{8}$ Miles North

1951

Elev. 2301' REPORT

10/24

Location

1952

1/16

Spud 10-27-51

Gas well TD 7731' 13" @ 324

9-5/8" @ 2537

DST 2518-80 open 16 min, rec 75' mud

Hol. 2489' Her 2516' Kri 2585'

Win. 2600' Towanda 2670'

Heeb 4402' Lans. 4576'

DST 5244-70 open 1 hr. rec 12' mud,
90' gas.DST 5160-5270' open 1 hr. rec 320'
mud.DST 5274-5317 open $\frac{1}{2}$ hr. rec 60' mud

DST 5336-5400 open 1 hr. rec 96' mud

Cored 5630-58 rec 3' sh. 10' hd
lmstone.

DST 5650-5732 open 1 hr. rec 88' mud

Cored 5738-41, rec $1\frac{1}{2}$ ' hd limestone.DST 5734-63 open 53 min. gas in 6 min
rec 80' GCM.

DST 5770-5825 open 1 hr, rec 20' mud

Morrow 5673' Miss 5723'

DST 7418-7608, open 1 hr. rec 390'
mud & water.DST 7595-7730 open 1 hr, rec 285' mud
120' SW

TD 7731' 7" @ 5939 Lans. 4585'

OVER

1952
1/16

(Information continued)

Morrow 5673' Chester 5720'

St. Gen. 6027' St. Lewis 6214'

Spurgeon 6374' Burlington 6856'

Fern Glen 7238' Viola 7421'

Simp. 7502' Arb. 7580'

90/ 5743-58 11,000 A

Test 11 MCFGPD

Comp. 11 MCFGPD


COMPLETED

County Meade State Kansas
 Sec. 29 (Blk. 33) (Sur. 2 6W) Map No.

Operator Deep Rock

Well No. 1 Farm Horner

Elev. 2301 Location C NW NW

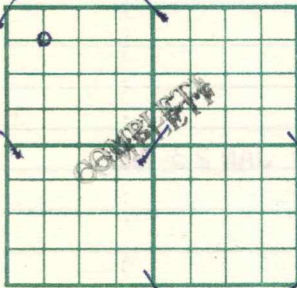

660 Ft. From N Line NW

660 Ft. From W Line Quarter

1st. Report

Completion JAN 16 1952

Remarks Wildcat

Rine Drlg. - Contr.

Spudding Date 10-27-51

Drig. Data Gas well TD 7731

13" @ 324 9 5/8" @ 2537 DST 2518-80

open 16 min. Rec. 75' mud Hol. 2489

Her. 2516 Kri. 2585 Win. 2600

Towanda 2670 Heeb. 4402 Lans. 4576

DST 5244-70 open 1 hr. Rec. 12' mud

90' gas DST 5160-5270 open 1 hr.

Rec. 320' mud DST 5274-5317 open 1/2 hr.

Rec. 60' mud DST 5336-5400 open 1 hr.

Rec. 96' mud Cored 5630-58 Rec. 3' sh.

10' hd. limestone DST 5650-5732 open 1 hr

Rec. 88' mud Cored 5738-41 Rec. 1 1/2'

hd. limestone DST 5734-63 open 53 min.

gas in 6 min. Rec. 80' gcm DST 5770-5825

open 1 hr. Rec. 20' mud Morrow 5673


J. E. TYRA

County Meade State Kansas
 Sec. 29 (Blk. 33) (Sur. 26W) Map No.

Operator Deep Rock

Well No. 1 Farm Horner

Elev. Location C NW NW

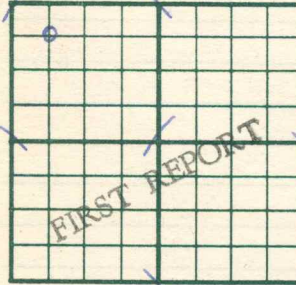

660 Ft. From N Line NW

660 Ft. From W Line Quarter

1st. Report OCT 24 1951

Completion

Remarks Deep test

Rine Drlg. - Contr.

Spudding Date

Drig. Data

Wildcat

MDPC has acreage 2 1/2 miles North

J. E. TYRA

Orig. Data

Miss. 5723 DST 7418-7608 open 1 hr.
Rec. 390' mud & water DST 7595-7730
open 1 hr. Rec. 285' mud 120' sw
TD 7731 7" @ 5939 Lans. 4585
Morrow 5673 Chester 5720 St. Gen. 6027
St. Lewis 6214 Spurgeon 6374
Burlington 6856 Fern Glen 7238
Viola 7421 Simp. 7502 Arb. 7580
90/ 5743-58 11000 A test 11 mcfgpd
Comp. 11 mcfgpd

JAN 23 1952

Scout Cards
Land Small Map
Land Wall Map
Tracings
France Map
Pierce Map
Misc.