


Section 32 Township 33 Range 26W

Well No. #1 Schroeder

Company Skelly oil

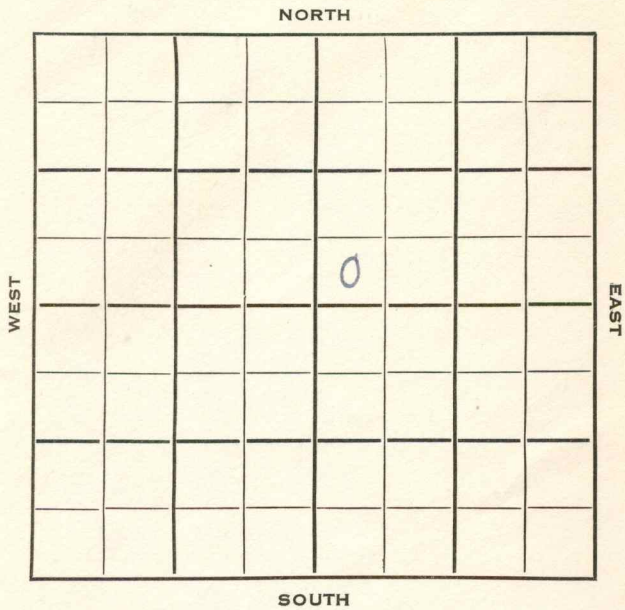

Sec. 32 Twp. 33 R. 26W

Well No. #1 Schroeder Farm

Skelly Company

McKinney Gas Pool Contractor


_____ Ft. from N. Line

330 Ft. from S. Line

_____ Ft. from E. Line

330 Ft. from W. Line

SW SW NE

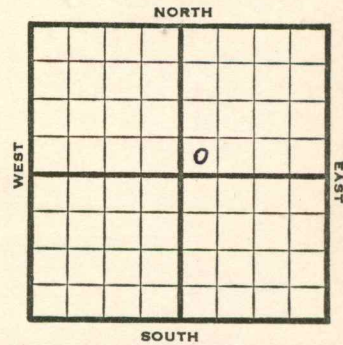

1953 Elev. 2367' REPORT

5/6 WOR
 5/21 N.R.
 5/28 WOR
 6/3 9" @ 1334
 Drlg. 1858'
 6/10 Drlg. 3821'
 6/24 Lans 4672, Marm 5324, Cherokee 5507
 Drlg. 5647'
 7/1 NR
 7/29 Spud 5-28-53
 Gas Well
~~TD 5980~~ TD 5980
 9" @ 1334
 Lans 4672, Marm 5324, Cherokee 5507,
 Morrow sh. 5779, Chester 5811
 DST 5778-5838, opn 1 hr., rec. 1350'
 gas, 75' sgcm, 300#
 DST 3833-91, opn 1 hr., 34,000 gas,
 150' gcm, 850 #
 DST 5884-5944, rec. 1800' gas, 130'
 gcm,
 5" @ 5975
 TD 5980, 219/5909-55, A-frac, 160,000
 gas, 5000A, 475,000 gas, 4000A

OVER

(Information Brought Forward)

1953

7/29

900,000 gas,
PB 5888
60/5858-68, 900,000 gas, 1000A
PB 5847, 24/5837-39, 132/5815-37,
2000A, 1,470,000 gas,
CO to 5962, 4000A
Comp. 2,400,000 gas

COMPLETED

1954

1/20

Chester 5811' OTD 5975'
5" @ 5975' PB 5935'
Gauge 1,400,000 gas 45 GWP
Testing

O.W.W.O.

2/24

Gas Well
TD 5975'
Chester 5811'
OTD 5975'
5" @ 5975'
PB 5935'
gauge 1,400,000 gas 45 gwph
CO to 5959' PB 5954
1 mcfg 90 gwph
PB 5856'
CO to 5935'
SW
PB 5795'
12/ 5786-90 CO to 5959'
Comp 350,000 gas 8 gswph

COMPLETED

