


Section 26 Township 33 Range 12W

Well No. #1 Mongone "B"

Company Cities Service

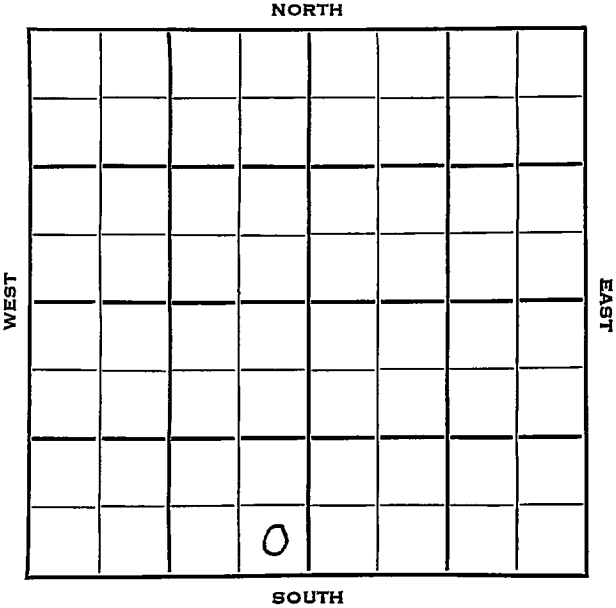

WELL NO.

#1 Mongone "B"

FARM

COMPANY

Cities Service

CONTRACTOR

Greenwood Gas Pool

NORTH


Ft. from N. Line

330 Ft. from S. Line

330 _____ Ft. from E. Line

Ft. from W. Line

SE SE SW

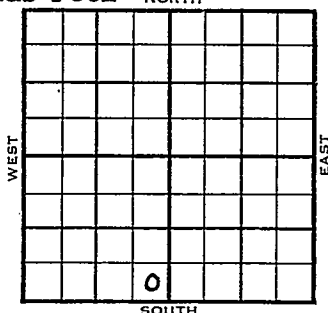

1953

ELEVATION

3385⁸

REPORT

9/30

Spud 9-24-53
8" @ 600'
Drlg 2225'

10/7

RTD 3400
5" @ 3399

11/11

Spud 9-24-53

Gas Well

TD 3400'

8" @ 600'

TD 3400:

511 @ 33991

CO to 3268

30/3220-26, 20/3211-15, 40/3198-3206,
40/3186-94, 20/3177-81, 50/3160-70,
70/3142-56, SSG, 7000A, 4,050,000 gas
PB 3071', 210/3008-50, 1,180,000 gas,
6000A

CO to 3 399', 2.0/800,000 gas,

PB 2965, 50/2936-46, 40/2918-26.

20/2906-10, 70/2880-94, 5000A

CO to 3399, 4000A

23,100,000 gas, 4000A

Top 2878, Lans 3136'

Comp. 26,200,000 gas, 434#

COMPLETED

County Morton State Kansas

Sec.	26	(Blk.) (Twp.)	33	(Sur.) (Rge.)	424	Map No.
------	----	------------------	----	------------------	-----	---------

Operator Cities Service


Elev.	Location	SE	SE	SW
-------	----------	----	----	----


330 Ft. From Line Quarter

1st. Report SEP 3 0 1

Completion

Remarks

Spudding Date 9-24-53

Drig. Data Greenwood Gas Pool

8" @ 600 d=15.2225

J. G. McGEHEE

County Morton State Kansas

Sec.	26	(Blk.) (Twp.)	33	(Sur.) (Rge.)	42W	Map No.
------	----	------------------	----	------------------	-----	---------

Operator	Cities	Service
----------	--------	---------

Well No. 1 Farm Mongone "B"

Elev.	3385	Location	SE SE SW
-------	------	----------	----------

COMPLETE

330 Ft. From S Line SW

330 Ft. From E Line Quarter

1st. Report _____

Completion NOV 11 1953

Remarks Greenwood Gas Pool

Spudding Date 9-24-53

Drlg. Data Gas well TD 3400

8" @ 600 TD 3400 5" @ 3399

C0 to 3268 30/ 3220-26 20/ 3211-15

40/ 3198-3206 40/ 3186-94 20/ 3177-81

50/ 3160-70 70/ 3142-56 SSG 7000 A

4,050,000 gas PB 3071 210/ 3008-50

1,180,000 gas 6000 A CO to 3399

20,800,000 gas PB 2965 50/ 2936-46

40/ 2918-26 20/ 2906-10 70/ 2880-94

5000 A CO to 3399 4000 A

23,100,000 gas 4000 A Top. 2878

Lans. 3136 Comp. 26,200,000 gas 434#

J. G. McGEHEE