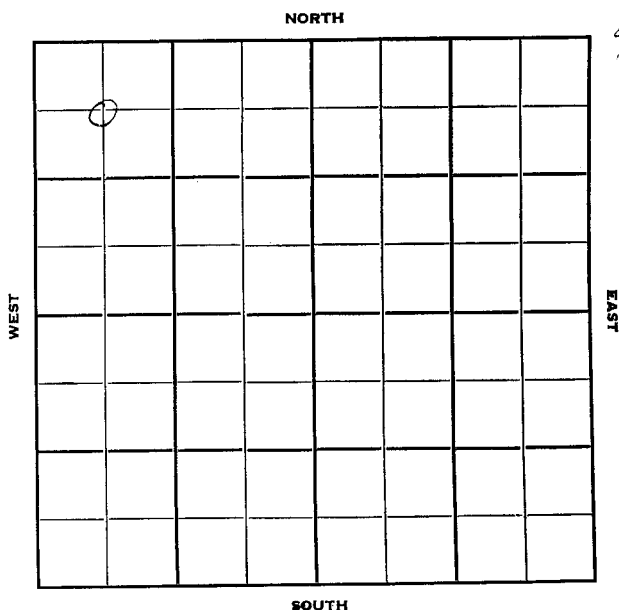


Section 26 Township 33 Range 30-WWell No. #1 NovingerCompany Columbia & United Prod.

KANSAS

Meade

30-W

Sec. 26 Twp. 33 R. 30-W

Well No. #1 Novinger Farm

Columbia & United Prod Company

Contractor

Wildcat

660

Ft. from N. Line


Ft. from S. Line

Ft. from E. Line

660

Ft. from W. Line

C NW NW

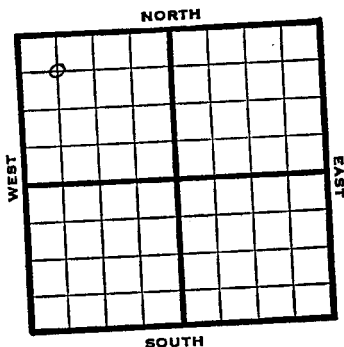

1950

Elev. 2706'

REPORT

10/11

Location

Miss Test

1951

5/23

Spud 10-15-50

Oil well TD 6637' 13-3/8" @ 670'

9" @ 2714'

DST 3486-3525 open 50 min. rec 2000'

SGCSW

Lans. 4575'

DST 5202-14 open 1/2 hr. rec 20' M & GCW

630' GCW, Marmaton 5233'

DST 5269-79 open 68 min. gas in 17 min
rec 500' clean green oil, 100' muddy
oil, 150,000 gas

DST 5280-99' open 1 hr. gas in 11 min
rec 119,000 gas, 790' clean green oil,
120' SMC oil

DST 5528-88' open 47 min. rec 15' drlg
mud,

DST 5771-79 open 1/2 hr. rec 10' mud

DST 5807-5900 open 1 hr. rec 165' SO
& GCM Miss. 5835'

DST 5912-83' open 1/2 hr. rec 10' mud

DST 5905-83 open 1 hr. rec 450' O & GCM

DST 6465-71 open 1 hr. rec 60' mud

TD 6637' PB 5935'

5" @ 5904 90/5817-32 84/5803-17

5000 A S/4 B0 8 hr. 15% BS

OVER

1951

5/23

(INFORMATION BROUGHT FORWARD)

2500 A S/36 BO 12 hr.

S/48 BO 12 hr. S/27 BO 12 hr.

3000 A S/40 BOPD 5000 A

P/325 BO 6 days P/66 BOPD

PB 5340' 16/5300-02 24/5263-66

1000' SW SP 5243' 24/5252-58'

160/5270-90 S/10 BOPH 500 A


F/378 BO 3 hr. F/369 BO 9 hr.

F/45 BOPH for 10 hr.

Comp. bomb pot. 1675 BOPD

370,000 gas

COMPLETED

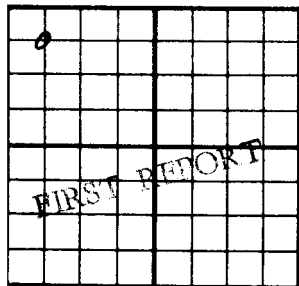County **Meade** State **Kansas**Sec. **26** (Blk.) **33** (Sur.) **30W** Map No.Operator **Columbia & United Prod.**Well No. **1** Farm **Novinger**Elev. Location **C NW NW****660** Ft. From **N** Line **NW****660** Ft. From **W** Line **Quarter**1st. Report **OCT 11 1950**

Completion


Remarks **Miss. test**

Spudding Date

Orig. Data **Wildcat****Location**

J. E. TYRA

County Meade State Kansas
 Sec. 26 (Blk. Twp.) 33 (Sur. Rge.) 30W Map No. _____
 Operator Columbia Fuel & United Prod.
 Well No. 1 Farm Novinger
 Elev. 2706 Location C NW NW

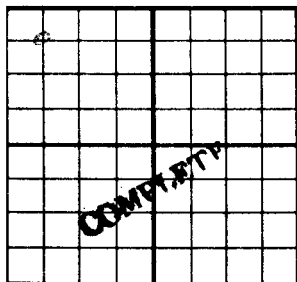

660 Ft. From N Line NW
660 Ft. From W Line Quarter
 1st. Report 500' 10' 10'
 Completion MAY 23 1951
 Remarks Wildcat
 Spudding Date 10-15-50

Drilg. Data Oil well TD 6637
13 3/8" @ 670 9" @ 2714 DST 3486-3525
open 50 min. Rec. 2000' sgcsw Lans. 4575
DST 5202-14 open 1/2 hr. Rec. 20' m & gcw
630' gcw Marmaton 5233 DST 5269-79
open 68 min. gas in 17 min. Rec. 500'
clean green oil 100' muddy oil
150,000 gas DST 5280-99 open 1 hr.
gas in 11 min. Rec. 119,000 gas 790'
clean green oil 120' smc oil DST 5528-86
open 47 min. Rec. 15' drlg. mud
DST 5771-79 open 1/2 hr. Rec. 10' mud
DST 5807-5900 open 1 hr. Rec. 165'
so & gcm Miss. 5835 DST 5912-83
open 1/2 hr. Rec. 10' mud DST 5905-83

J. E. TYRA

Drig. Data

open 1 hr. Rec. 450' o & gcm DST 6465-71
 open 1 hr. Rec. 60' mud TD 6637 PB 5935
 5" @ 5904' 90/ 5817-32 84/ 5803-17
 5000 A S/ 4 bo 8 hr. 15% bs 2500 A
 S/ 36 bo 12 hr. S/ 48 bo 12 hr.
 S/ 27 bo 12 hr. 3000 A S/ 40 bopd
 5000 A P/ 325 bo 6 days P/ 66 bopd
 PB 5340 16/ 5300-02 24/ 5263-66
 1000' sw SP 5243 24/ 5252-58 160/ 5270
 90 S/ 10 boph 500 A F/ 378 bo 3 hr.
 F/ 369 bo 9 hr. F/ 45 boph for 10 hr.
 Comp. bomb pot. 1675 bopd 370,000 gas

Scott Cards	
Land Small Map	
Land Wall Map	
Tracings	
France Map	
Pierce Map	
Misc	

Wille

MAY 29 1951