


Section 26 Township 33 Range 30 W

Well No. # 8 Novinger

Company Columbian Fuel

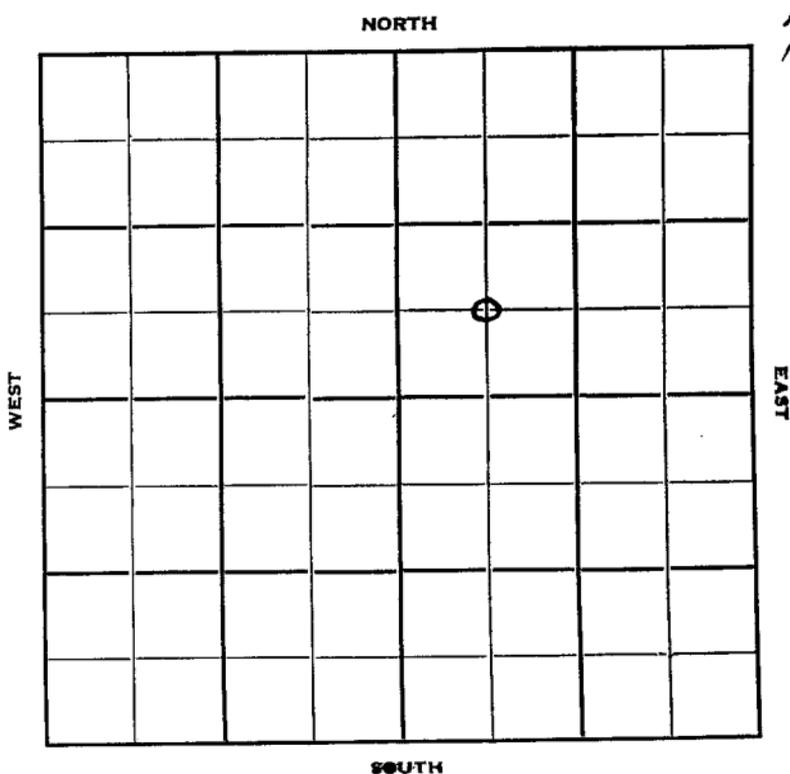




County Meade State Kansas

Sec. 26 (Blk. 33 (Sur. Rge.) 30W Map No.

Operator Columbian Fuel

Well No. 8 Farm Novinger

Elev. 2710 Location C SW NE

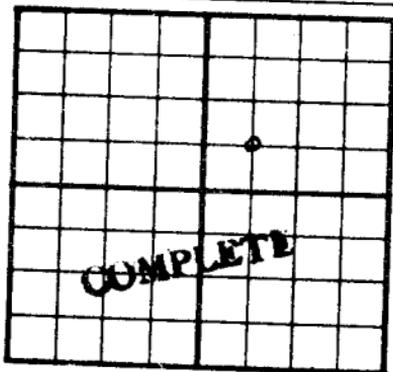

660 Ft. From S Line NE

660 Ft. From W Line Quarter

1st. Report

Completion JUN 11 1952

Remarks Novinger Pool

Helmerich & Payne - Cont

Spudding Date 3-20-52

Drig. Data Oil well TD 5326

13" @ 634 8" @ 2702 DST 5301-20

open 1 hr. Rec. 1780' oil 10' ocm

TD 5340 5" @ 5340 B. Blaine 983

B. Steencorrell 1683 Hol. 2644

Her. 2698 Kri. 2771 Win. 2823

Ft. Riley 2890 Florence 3005

Lans. 3484 Marm. 5306 CO to 5326

12/ 5287-89 FU 7 bw 4 hr. DD 5326

36/ 5204-14 S/ 4" boph 500 A S/ 7 boph

Comp. 130 bopd

J. G. McGEHEE