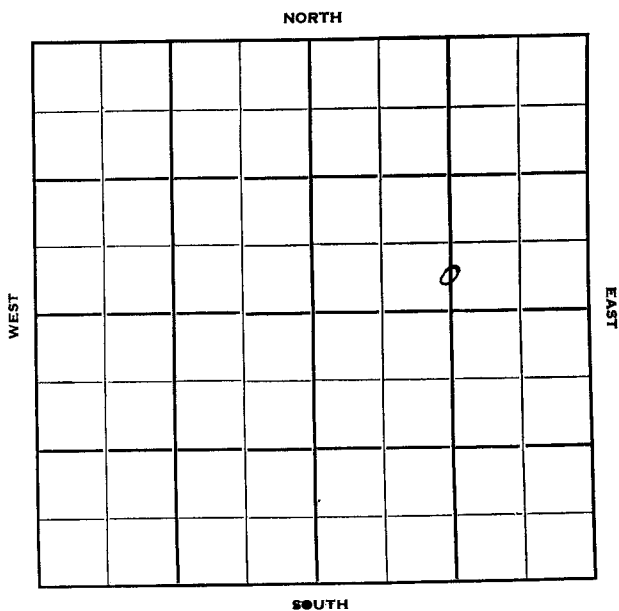


Section 26 Township 33 Range 34-WWell No. #1 SchmidtCompany Cabot Carbon

Seward

Sec. 26 Twp. 33 R. 34W

Well No. #1 Schmidt ☒ Farm

Cabot Carbon Company

Contractor

Hugoton Pool


 Ft. from N. Line

330' Ft. from S. Line

1320' Ft. from E. Line

 Ft. from W. Line

C S L S $\frac{1}{2}$ NE

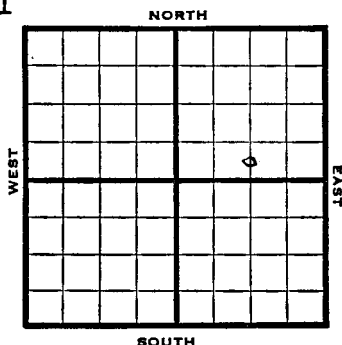

1950 Elev. 2905' REPORT

12/27 Cellar & Pits

1951

5/2

Spud 2-13-51

Gas Well TD 2720


10" @ 574 7" @ 2648

TD 2720

Her. 2645 Krider 2670'

20,000 A Comp. 202,000 gas 419#

COMPLETED

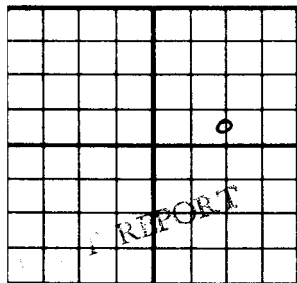County **Seward** State **Kansas**Sec. **26** (Blk.) **33** (Sur.) **34W** Map No.Operator **Cabot Carbon**Well No. **1** Farm **Schmidt**Elev. Location **C S L S $\frac{1}{2}$ NE****330** Ft. From **S** Line **NE****1320** Ft. From **E** Line Quarter1st. Report **DEC 27 1950**

Completion


Remarks

Spudding Date

Orig. Data

Hugoton Pool**Cellar & pits**

J. E. TYRA

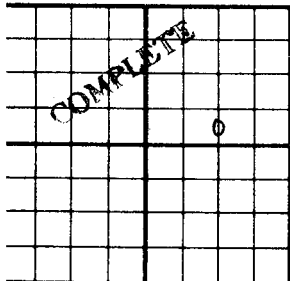County Seward State KansasSec. 26 (Bk.
Twp.) 33 (Sur.
Rge) 34th Map No.Operator Cabot CarbonWell No. 1 Farm SchmidtElev. 2905 Location C S L S $\frac{1}{2}$ NE330 Ft. From S Line NE1320 Ft. From E Line Quarter

1st. Report

Completion MAY 2 1951Remarks Hugoton PoolSpudding Date 2-13-51Orig. Data Gas well TD 272010" @ 574 7" @ 2648 TD 2720Per. 2645 Krider 2670 20000 AComp. 202,000 gas 419 $\frac{1}{2}$

J. E. TYRA