
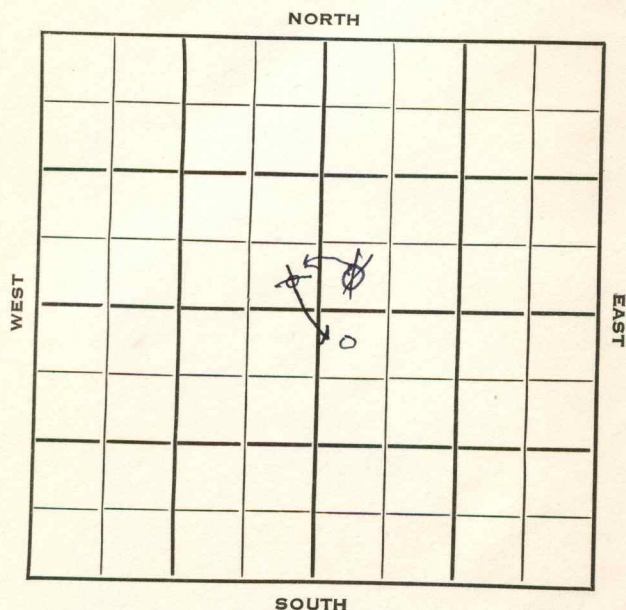


Section 11 Township 33 Range 27WWell No. #1 EdigerCompany Skelly OilSec. 11 Twp. 33 R. 27WWell No. #1 Ediger FarmSkelly Oil Company

Contractor

330 Ft. from N. Line330 Ft. from S. Line330 Ft. from E. Line330-330 Ft. from W. Line~~SE SE NW~~~~SW SW NE~~

NW NW SE

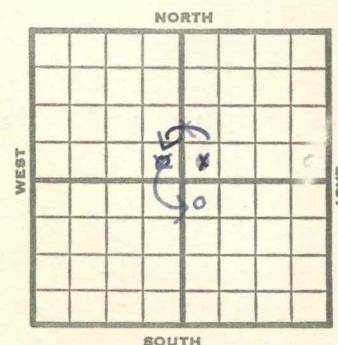

1953

Elev. 2418'

REPORT

8/19	Location
8/26	"
9/16	8" @ 1346'
9/23	Drlg 2884'
9/30	Heeb 4450' Tor 4460' Lans 4624'
	Drlg. 4810'
10/7	DST 4780'-4823' 1 hr, 360' SW, 1520#
	Marm 5240'
	Drlg 5325'
10/14	Drlg.
11/4	Spud 9-11-53
	Gas Well
	TD 6111'
	8" @ 1346'
	Heeb 4450, Tor 4460, Lans 4624
	DST 4780-4823, opn 1 hrs., rec.
	360' sw, 1520#
	Marm 5240', Cherokee 5426', Morrow
	5671', Morrow sd, 5673'
	DST 5670-5744, opn 1 hr., rec. 2
	mcf, 20' gcm, 1875#
	DST 5722-79, opn 3/4 hrs., rec. 3/4
	mcf, 90' mud, 1940#
	DST 5803-5979, opn 1 hr., rec. 20'
	mud, 100#

OVER


(Information Brought Forward)

1953
11/4

DST 5988-6043, opn 3/4 hrs., rec.
30' mud,
St. Gen. 6062'
DST 5966-6026, opn 1½ hrs., rec.
930' sw, 2650#
TD 6111'
5" @ 6048
CO to 6006, 138/5715-38,
F/124 bw 2000A
6,125,000 gas, 6000A
8½ mcfg, 6000A
7 mcfg
SP 5708
PB 5704
30/5686-91, SP 5674
Sd-oil-frac, 4,300,000 gas
CO to 6004, 5½ mcfg
Comp. shut in gas well
5½ mcfgpd

COMPLETED

County Meade State Kansas
 Sec. 11 (Blk. 33) (Sur. 27W) Map No.
 Operator Skelly Oil
 Well No. 1 Farm Ediger
 Elev. 2418 Location NW NW SE

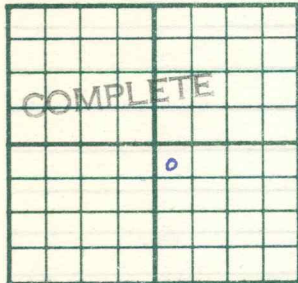

330 Ft. From N Line SE
330 Ft. From W Line Quarter

1st. Report
 Completion NOV 4 1953
 Remarks

Spudding Date 9-11-53

Drig. Data Gas well TD 6111
8" @ 1346 Heeb. 4450 Tor. 4460
Lans. 4624 DST 4780-4823 open 1 hr.
Rec. 360' sw 1520# Marm. 5240
Cherokee 5426 Morrow 5671 Morrow sd.
5673 DST 5670-5744 open 1 hr. Rec.
2 mcfg 20' gcm 1875# DST 5722-79
open 3/4 hr. Rec. 3/4 mcfg 90' mud
1940# DST 5803-5979 open 1 hr. Rec.
20' mud 100# DST 5988-6043 open
3/4 hr. Rec. 30' mud St. Gen. 6062
DST 5966-6026 open 1 1/2 hr. Rec. 930' sw
2650# TD 6111 5" @ 6048 CO to 6006
138/ 5715-38 F/ 124 bw 2000 A
6,125,000 gas 6000 A 8 1/2 mcfg 6000 A

J. G. McGEHEE

County Meade State Kansas
 Sec. 11 (Blk. 33) (Sur. 27W) Map No.
 Operator Skelly Oil
 Well No. 1 Farm Ediger
 Elev. Location SW SW NE



330 Ft. From S Line NE
330 Ft. From W Line Quarter

1st. Report AUG 19 1953
 Completion
 Remarks

Spudding Date

Drig. Data
Location

J. G. McGEHEE

Drig. Data

87 mcfg SP 5708 PB 5704 30/ 5686-91

SP 5674 sd-oil-frac 4,300,000 gas

CO to 6004 ~~5 $\frac{1}{2}$ mcfg~~

Comp. shut in gas well ~~5 $\frac{1}{2}$ mcf gpd~~

Scout Cards
Land Grant Map
Land Wall Map
Tracting
France Map
Misc

NOV 10 1953

Kansas

Map No. _____ Sec. 11 Twp. 33 R. 27WWell No. 1 Ediger

_____ Skelly Oil _____ Company

_____ **CORRECTION** _____ Contractor


SE SE NW

SECTION PLAT

_____ Ft. from N. Line

330 Ft. from S. Line330 Ft. from E. Line

_____ Ft. from W. Line

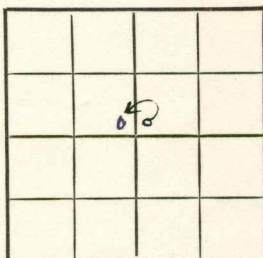

Meade County

Location _____

Rig up _____

Drilling and Remarks:

Reported
SW SW NE

RECORD

Cased _____ in., _____ ft.

Sand _____

Gas _____

Oil _____

Total Depth _____

PRODUCTION

1st 24 hrs. Nat. _____

1st 24 hrs. after shot _____

Gas _____ Cu. Ft.

Dry Hole _____

Abandoned _____

Date

SEP

2

1952

19

J. G. McGEHEE

Scout

Kansas

Map No. _____ Sec. 11 Twp. 33 R. 27WWell No. 1 Ediger

_____ Skelly Oil _____ Company

_____ **CORRECTION** _____ Contractor


NW NW SE

SECTION PLAT

330 Ft. from N. Line

_____ Ft. from S. Line

_____ Ft. from E. Line

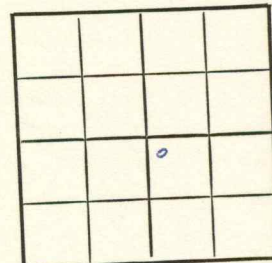330 Ft. from W. Line

Meade County

Location _____

Rig up _____

Drilling and Remarks:

Recorrected
from

SE SE NW

RECORD

Cased _____ in., _____ ft.

Sand _____

Gas _____

Oil _____

Total Depth _____

PRODUCTION

1st 24 hrs. Nat. _____

1st 24 hrs. after shot _____

Gas _____ Cu. Ft.

Dry Hole _____

Abandoned _____

Date

OCT

7

1953

19

J. G. McGEHEE

Scout