


SECTION 14 TOWNSHIP 33S RANGE 27W

WELL NO. #1 Merton-Horner "C"

COMPANY Graham-Michaelis

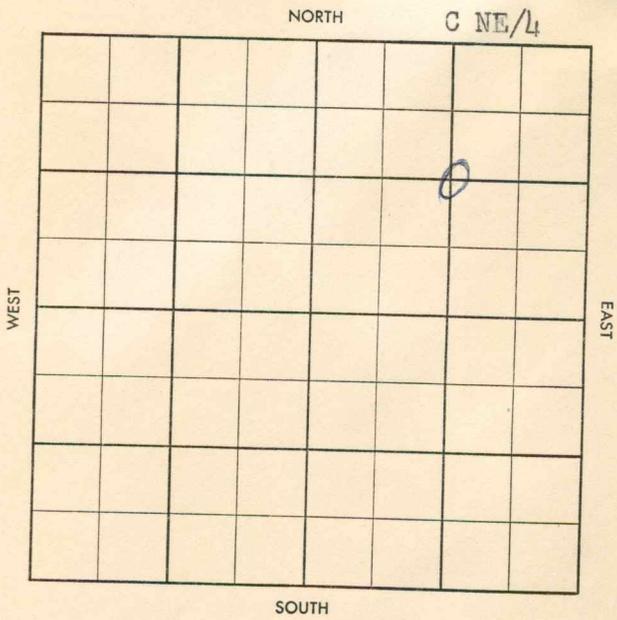

28

S-513-B

County Meade Elev. _____
 Sec. 14 Twp. 33 Rge. 27W
 Company Graham-Michaelis
 Farm Name Merton-Horner "C" No. 1

TOPS	DEPTH	LOG	DATUM	Loc. in Sec.
Anh.				C NE/4
Tp.				
H.				
Tr.				
Dg.				
B.L.				
L.				
K.C.				
B.K.C.				
Ce.				
C.				
M.				
M.				
K.				
Mz.				
Mq.				
V.				
S.				
S.				
A.				
R.				
Pf.				
G.				
T.D.				

Co. Tools #3

Pool

McKinney



Date Comm. 1/27/58
 Drlg. 419

NO. SEC. T. R.

Twp. ~~33~~ Pool ~~27W~~
 Co. ~~Meade~~ Facet ~~1~~

S-513-B

County Meade Elev. 2412 DF-344548
 Sec. 14 Twp. 33 Rge. 27W
 Company Graham-Michaelis
 Farm Name Merton-Horner "C" No. 1

TOPS	DEPTH	LOG	DATUM	Loc. in Sec.
Anh.				
Tp.				<u>C NE/4</u>
H.	<u>4476</u>			
Tr.	<u>4485</u>			
Dg.				
B.L.				
L.	<u>4649</u>			
K.C.				Geol.
B.K.C. <u>MOESA</u>		<u>5700</u>		Contr.
Ce. <u>" 90"</u>		<u>5714</u>		<u>Co. Tools #3</u>
C. <u>Phenton</u>		<u>5740</u>		Pool
M.				<u>McKinney</u>
M.				
Mz.				
Mq.				
V.				
S.				
S.				
A.				
R.				
Pf.				
G.				
T.D.	<u>5805</u>			

APR 23 '58
 ABANDONED

Date Comm. 1/27/58
 Drig. 419 FEB 9 '58 10" 602/408
Ø 2562 FEB 12 '58 Ø 4188 FEB 19 '58
Ø 5329 MAR 26 '58 DST 5674-5785
90" Ø 14" 90" 143 met 190"
run 175' gem FP45-70 RHP
14551/2 52 5304/80 MAR 5 '58 woc
 MAR 12 '58 12/ 5751-54 1/2 510g swph
NT NG SQ woc MAR 19 '58 8/ 5771-73
8/ 5776-78 618 g swph + 59
T STM NT SQ 24/ 5720 -26

ga 130 met + 5g wph 2 1/2 hrs
 ga 923 met + 10g wph 12 hrs
 channeled SQ MAR 26 '58 20/5719-24
 ga TSTM 50g wph 12 hrs
 SQ CO 5731 report 70/5719-24
 30g wph TSTM 6 hrs
APR 2 '58 SQ all parts CO APR 2 '58
 18/5721-24 ga 100 met + 10-15
 g wph Erac 8x5 ga 130 met
 + 1B wph ? 5782 ga 380 met
 + 1B wph $\frac{1}{2}$ + 5tg APR 16 '58
 PB 3722 $\frac{1}{2}$ Δ ga 350 met + 30g wph
APR 7 '58
 to Vibro Erac ga 1.40 met
 2 1/2 hrs sip 700 wet dew 431
 met + 30 g wph

D6A

1A-33-27W

CNE/4