

Meade


KANSAS

SECTION 13 TOWNSHIP 33 RANGE 27W

WELL NO. #1 M.A. Horner "B"

COMPANY Graham-Michaelis

*Exp with NW
C-NW/4*

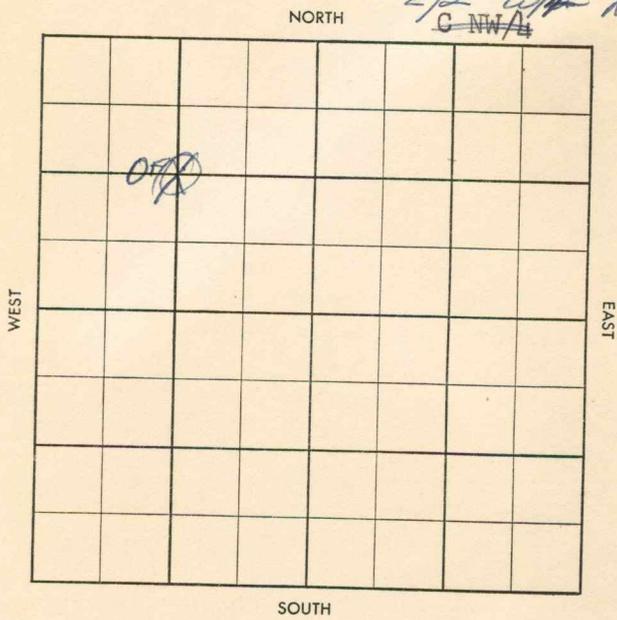

~~23~~

FORM 513 SUNRAY

County Meade Elev. _____
 Sec. 13 Twp. 33 Rge. 27W
 Company Graham-Michaelis
 FarmName M. A. Horner No. 1

TOPS	DEPTH	LOG	DATUM	Loc. in Sec.
Anh.				C NW/4
Tr.				
H.				
Tr.				
Dg.				
Bl.				
L.				Geol. _____
K.C.				Contr. _____
B.K.C.				Co. tools _____
Ce.				Pool _____
C.				McKinney
M.				
Mz.				
Me.				
V.				
S.				
A.				
R.				
PE.				
G.				
T.D.				

Date Comm.

M I R

K-23
~~B~~

CORRECTION

FORM 513 SUNRAY

County Meade Elev. 2335 D.F.
 Sec. 13 Twp. 33 Rge. 27W
 Company Graham-Michaelis
 FarmName N. A. Horner "B" No. 1

TOPS	DEPTH	LOG	DATUM	Loc. in Sec.
Anh.				E NW/4
TP.				<u>E/2 NW/4 NW</u>
H.				
Tr.				
Dg.				
Bl.				
L.				
K.C.				Geol.
B.K.C. <u>Mash</u>		<u>5629</u>		Contr.
Ce. <u>" sd</u>		<u>5648</u>		Co. tools
C. <u>Chen</u>		<u>5676</u>		Pool
M.				<u>McKinney</u>
M.				
Mz.				
Ma.				
V.				
S.				
S.				
A.				
R.				
PE.				
G.				
ID.	<u>5780</u>			COMPLETE

Date Comm. M I R SEP 25 '57 9-21-57 4" 525/33
 Loss in 2663 OCT 2 '57 17 4416
 OCT 9 '57 17 5615 OCT 16 '57 DST
 5628 - 5750 1 hr 3 1/2" ga
 1.250 MCF run 300' H GCM
 FP 811-949 BHP 1986/30"
 run log 5 1/2" 5780/200
 OCT 23 '57 48/5692-5704 1/2
 ga 1.250 MCF (B) ga 5.500 MCF

FORM 513-1 SUNRAY BHP 5660

24/ 5642-47 500A / S
ga 6.500 MCF (S) 20
5708 ran TB9 STP # 500
ITD 825 2420 ga 12. MCF
NOV 6 '57 SI TP 825 #

13-33-27W

Cmw/4