
FORM 51

Meade KANSAS

Section 14 Township 33 Range 27W

Well No. 1 Ediger "B"

Company Skelly Oil & Deep Rock

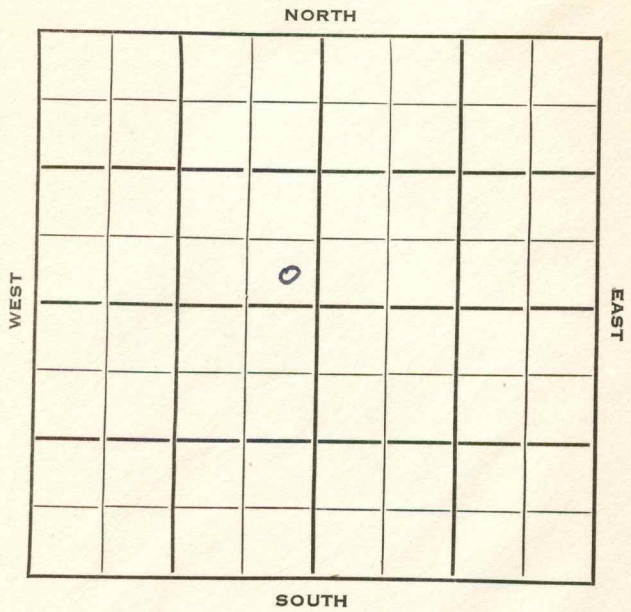

Meade KANSAS

SEC.	TWP.	R.
14	33	27 W

WELL NO.

1 Ediger "B" FARM

COMPANY

Skelly Oil & Deep Rock

CONTRACTOR


____ Ft. from N. Line

330 Ft. from S. Line

230 Ft. from E. Line

____ Ft. from W. Line

SE SE NW

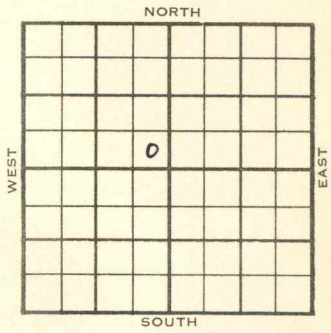

ELEVATION 2454

1954 REPORT

3/31 Location.

4/7 9½" @ 1340' w/800 sks

6/9 Spudding 4-11-54
D & A
TD 5889
9½ @ 1340
Heeb 4497 Lans. 4689 Marm 5307
Cherokee 5494 Morrow 5753 Chester-5781
DST 5748-5833 open 1 hr.
62,000 gas in ½ hr. Rec. 800' sw
1865# DST 5748-83 open 1 hr.
162,000 gas in ¼ hr. 88,000 gas in ½he. 800' sw DST 5837-86 open 3/4 hr.
REc. 5' mud 0#
5" @ 5926 CO to 5889 48/5792-5801
40 gswph PB 5785 .2/ 5772-85- 7
bswph PB 5785 12/ 5772-85 7 bswph
8/ 5778-82 VSSG 2 bwph.
D&A

ABANDONED

DX-78

FORM 275 FOR SALE BY KANSAS BLUE PRINT CO.

County Meade State Kansas

Sec. 14 (Blk. Twp.) 33 (Sur. Rge.) 27W Map No.

Operator Skelly Oil & Deep Rock

Well No. 1 Farm Ediger "B"

Elev. 2454 Location SE SE NW



330 Ft. From S Line NW

230 Ft. From E Line Quarter

1st. Report

Completion JUN 9 1954

Remarks

Spudding Date 4-1-54

Drlg. Data D & A TD 5889

9 1/2" @ 1340 Heeb. 4497 Lans. 4689

Marm. 5307 Cherokee 5494 Morrow 5753

Chester 5781 DST 5748-5833 open 1 hr.

62,000 gas in 1/2 hr. Rec. 800' sw 1865#

DST 5748-83 open 1 hr. 162,000 gas in 1/4 hr

88,000 gas in 1/2 hr. 800' sw DST 5837-86

open 3/4 hr. Rec. 5' mud 0# 5" @ 5926

CO to 5889 48/ 5792-5801 40 gswph

PB 5785 12/ 5772-85 7 bswph

8/ 5778-82 VSSG 2 bwph

D & A

J. G. McGEHEE

FORM 275 FOR SALE BY KANSAS BLUE PRINT CO.


County Meade State Kansas

Sec. 14 (Blk. Twp.) 33 (Sur. Rge.) 27W Map No.

Operator Skelly Oil & Deep Rock

Well No. 1 Farm Ediger "B"

Elev. Location SE SE NW

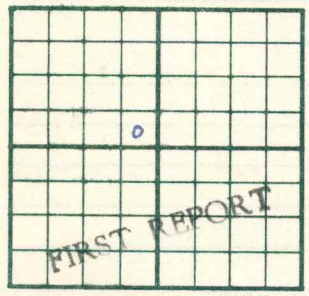

330 Ft. From S Line NW

230 Ft. From E Line Quarter

1st. Report MAR 31 1954

Completion

Remarks

Spudding Date

Drlg. Data

Location

J. G. McGEHEE