

Section 24 Township 33 Range 27 W

Well No. # 3 Horner

Company Gulf Coast Rice Farms, Inc.

Sec. 24 Twp. 33 R. 27W

Well No. #3 Horner Farm

Gulf Coast Rice Farms, Inc. Company

Contractor

McKinney Gas Pool



Ft. from N. Line

1320 Ft. from S. Line

Ft. from E. Line

1320 Ft. from W. Line

C SW/4

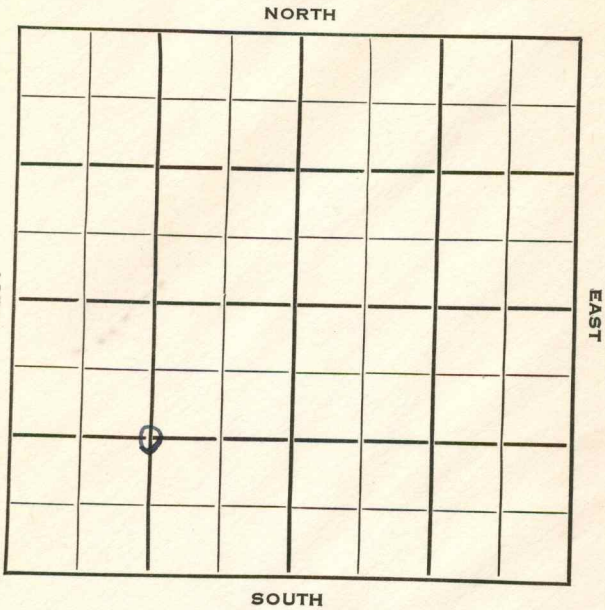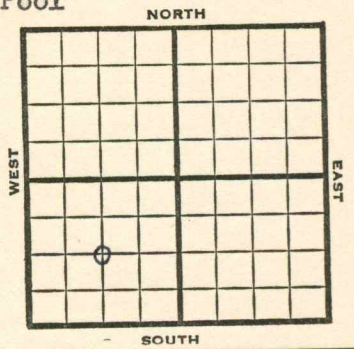

1953 Elev. 2402' REPORT

Date	Location
4/29	Location
5/7	"
5/21	"
5/28	"
6/3	"
6/24	"
7/1	9" @ 618'
7/8	Drlg. 3407'
7/22	Drlg 5664'
7/29	Drlg.
8,19	Spud 6-28-53 D&A TD 6076 9" @ 618 DST 5812-97, opn 1½ hrs., rec. 25' mud, 103# Morrow 5764, Miss 5817 TD 6076 5" @ 6070 114/5820-36, 1000A, 114/5864-80 1000A, SP 5807, PB 5605 D&A

ABANDONED

