


Section 27 Township 33 Range 42W

Well No. 1 Goddard "D"

Company CSO & Colorado Interstate

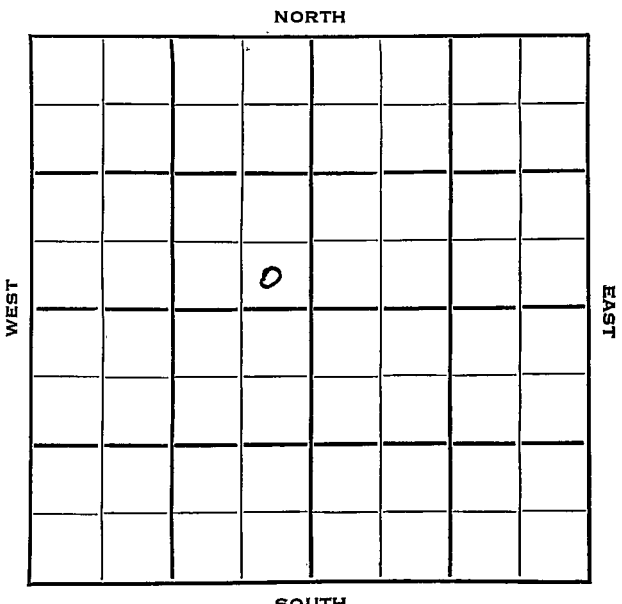

Morton

KANSAS

SEC.	TWP.	R.
27	33	42W ✓


WELL NO. 1 Goddard "D" FARM

COMPANY CSO & Colorado Interstate

CONTRACTOR

**Greenwood Gas Pool**

\_\_\_\_\_ Ft. from N. Line  
 330 \_\_\_\_\_ Ft. from S. Line  
 330 \_\_\_\_\_ Ft. from E. Line  
 \_\_\_\_\_ Ft. from W. Line

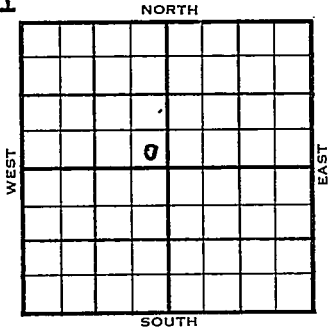

SE SE NW

	ELEVATION	REPORT
1953	3495'	

10/28 Spud 10-26-53  
 8" @ 600', WOC

11/4 DrLg 3300'

11/11 TD 3300'  
 5" @ 3299'  
 Anhy 1350', Top 2926', Lans 3186'

12/16 Spud 1026-53  
 Gas Well  
 TD 3300'  
 8" @ 600'  
 Anhy 1250, Top 2926, Lans 3186,  
 TD 3300'  
 5" @ 3299'  
 CO to 3290 100/ 3270-90 3000 A  
 210/ 3048-90 9,400,000 gas 6000 A  
 SP 3010 30/ 2982-88 40/ 2966-74  
 30/ 2954-60 70/ 2930-44 5000 A  
 CO to 3200  
 32, 600,000 gas 4000 A  
 Comp 35,500,000 cf/gpd 434#.

*Handwritten calculations:*  

$$\begin{array}{r} 3495 \\ - 2926 \\ \hline 569 \end{array}$$

$$\begin{array}{r} 3495 \\ - 3186 \\ \hline 309 \end{array}$$

**COMPLETED**



