


Section 27 Township 33 Range 30W

Well No. #2 Lagghofer

Company Columbian Fuel

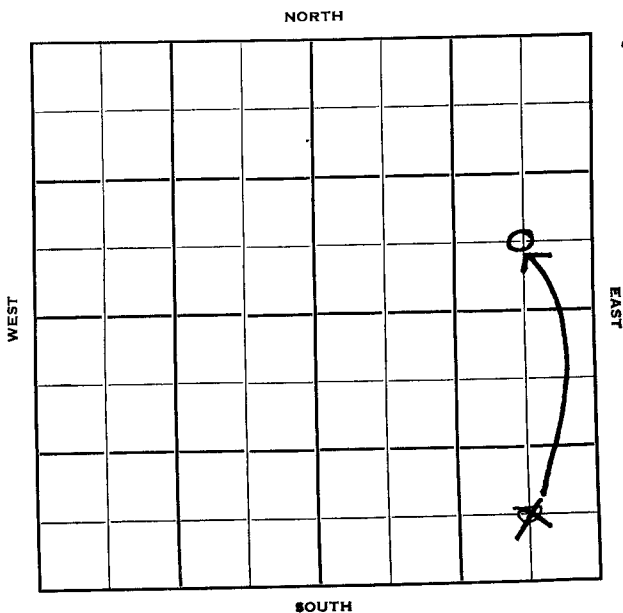

Meade KANSAS



Sec. 27 Twp. 33 R. 30 W

Well No. # 2 Langhofer Farm

Columbian Fuel Company

Contractor


 Ft. from N. Line

660 Ft. from S. Line

660 Ft. from E. Line

 Ft. from W. Line

~~C SE SE~~
C SE NE

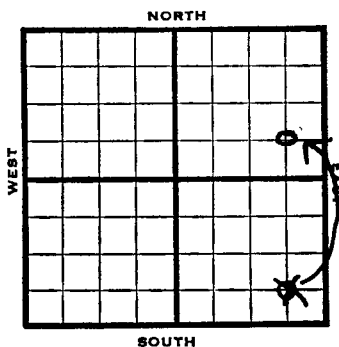


1952	Elev. 2712' REPORT
5/28	Spud 5-17-52 13" @ 626 w/500 Drlg. 1188' 8" @ 2695' Drlg. 2799'
6/11	PB 3453 to Whipstock
6/18	NR
6/25	Wellington 2126 Hol 2632 Her 2689 Drlg. 4482'
7/2	Cored 5269'
7/9	RTD 5323 5" @ 5321
7/17	NR
7/23	"
7/30	"
8/6	"
8/13	CO 12/5261-63 sq. off 42/5277-84 S/5 Boph 500 A S/9½ Boph for 6 hrs.
8/20	NR
8/27	"
9/3	"
9/10	Spud 5-17-52 Oil Well TD 5523' 13" @ 626 8" @ 2695 PB 3453
OVER	

L952

9/10 Wellington 2126 Hol. 2632
Her. 2689
DST 5267-5310' open 1 hr. rec 2670'
oil & 30' mud 1,755,000 gas in
20 min. 1245# TD 5323
5" @ 5321' 12/ 5261-63
42/ 5277-84 S/ 5 boph 500 A
S/ 9½ boph Comp. 333 bopd
Win. 2798 Ft. Riley 2860
Lans. 4452 Marm. 5243
TD 5323'

COMPLETED

County Meade State Kansas
 Sec. 27 (Blk. 33 (Sur. 30W Map No.
 (Twp.) (Rge.)
 Operator Columbian Fuel
 Well No. 2 Farm Langhofer
 Elev. 2712 Location C SE SE

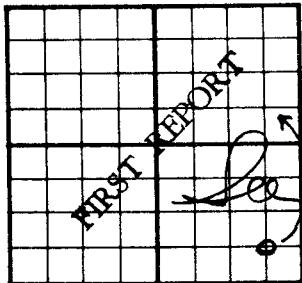

660 Ft. From S Line SE
660 Ft. From E Line Quarter

1st. Report MAY 28 1952

Completion

Remarks


Correction

Spudding Date 5-17-52

Drlg. Data

13" @ 626 W/500 Drlg. 1188 8" @ 2695
Drlg. 2799

J. G. McGEHEE

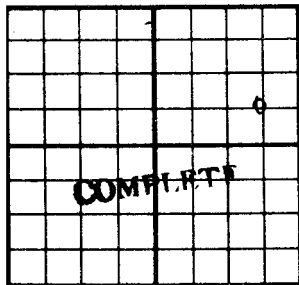County Meade State KansasSec. 27 (Blk.) 33 (Sur.) 30W Map No.Operator Columbian FuelWell No. 2 Farm LonghoferElev. 2704 Location C SE NE660 Ft. From S Line NE660 Ft. From E Line Quarter1st. ReportCompletion SEP 10 1952RemarksSpudding Date 5-17-52Drlg. Data Oil well TD 532313" @ 626 8" @ 2695 PB 3453Wellington 2126 Hol. 2632 Her. 2689DST 5267-5310 open 1 hr. Rec. 2670'oil & 30' mud 1,755,000 gas in 20 min.1245# TD 5323 5" @ 5321 12/ 5261-6342/ 5277-84 S/ 5 boph 500 AS/ 9½ boph Comp. 333 bopdWin. 2798 Ft. Riley 2860 Lans. 4452Marm. 5243 TD 5323

J. G. McGEHEE

Kansas

Map No. _____ Sec. 27 Twp. 33 R. 30WWell No. 2 LonghoferColumbian Fuel

Company

CORRECTION

Contractor

C SE NE

SECTION PLAT

			0

_____ Ft. from N. Line

660 Ft. from S. Line660 Ft. from E. Line

_____ Ft. from W. Line

Meade County

RECORD

Location _____

Cased _____ in., _____ ft.

Rig up _____

Sand _____

Drilling and Remarks:

Gas _____

Oil _____

Total Depth _____

Reported

PRODUCTION

C SE SE

1st 24 hrs. Nat. _____

1st 24 hrs. after shot _____

Gas _____ Cu. Ft.

Dry Hole _____

Abandoned _____

Date

JUN 4 1952 19J. G. W. GEE

Scout