

KANSAS

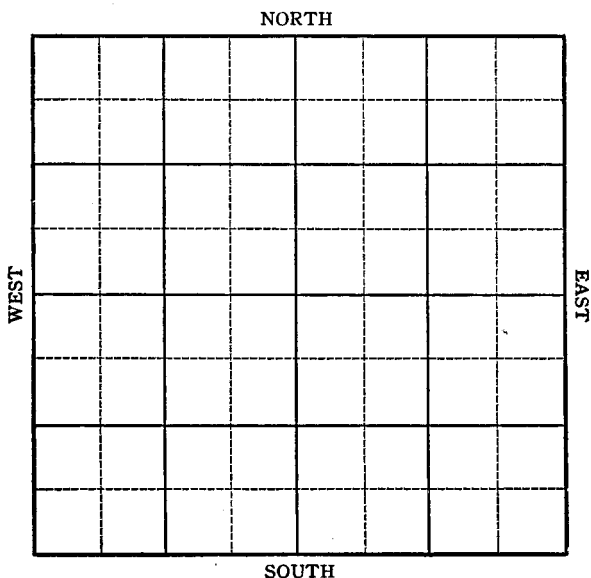
Stevens County

FORM 51 5M PETROL

Section 27 Township 33 Range 38W

Well No. 2 Coulter

Company Republic Nat. Gas



KANSAS

Stevens

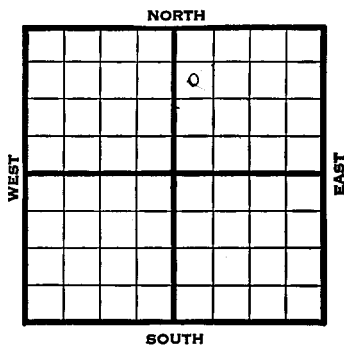
Sec. 27 Twp. 33 R. 38WWell No. 2 Coulter FarmRepublic Nat. Gas Company

Hugoton

1125 Ft. from N. Line

Ft. from S. Line

Ft. from E. Line

75 Ft. from W. LineC SW NW NE Elev. 3173

1945

REPORT

6/13	1427'
6/21	7" @ 2519 TD 2530 RUST
6/28	10" @ 587 Drlg. 2670
7/3	TD 2747 7,643,000 Gas.
7/11	" " " "
7/19	" " " "
7/26	" " " "
8/1	" " " "
8/8	" " " "
8/15	" " " "
8/22	" " " "
8/29	" " " "
8/5	" " " "
9/12	" " " "
9/19	7" @ 2519 12,500 acid. TD 2747' 23,047,000 Gas. 240' of 5" Perf. liner @ 2747 406# R Pr.

COMPLETED

Kansas Pool Name HugotonMap No. 27 Sec. 27 Twp. 33 R. 38WWell No. 2 CoulterRepublic Nat. Gas. CompanyFIRST REPORT

Contractor

C SW NW NE

SECTION PLAT

		o	

1125 Ft. from N. Line Ft. from S. Line Ft. from E. Line75 Ft. from W. LineStevens CountyLocation Rig up

Drilling and Remarks:

1427

RECORD

Cased in., ft.Sand Gas Oil Total Depth

PRODUCTION

1st 24 hrs. Nat. 1st 24 hrs. after shot Gas Cu. Ft.Dry Hole Abandoned

Date

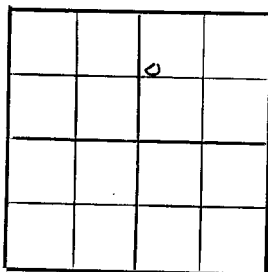
JUN 13 194519S. J. LEWISScout

KANSAS

Kansas Pool Name HugotonMap No. no map Sec. 27 Twp. 33 R. 38WWell No. 2 CoulterRepublic Nat. Gas Company~~COMPLETED~~

Contractor

SW NW NE

E 1/3 23
SECTION PLAT1500 Ft. from N. Line Ft. from S. Line Ft. from E. Line75 Ft. from W. Line

Stevens County

Location Rig up

Drilling and Remarks:

7" @ 251912,500 @ 251923,047,000 Gas240' of 5" Reg. Lines@ 2747406 " R/P

RECORD

Cased in., ft.Sand Gas Oil Total Depth 2747

PRODUCTION

1st 24 hrs. Nat. 1st 24 hrs. after shot Gas Cu. Ft.Dry Hole Abandoned

Date

SEP 19 1941

19

S. J. LEWIS

Scout