


KANSAS

Seward

Section 27 Township 33 Range 34-W

Well No. #1-27 N1x

Company Panhandle Eastern

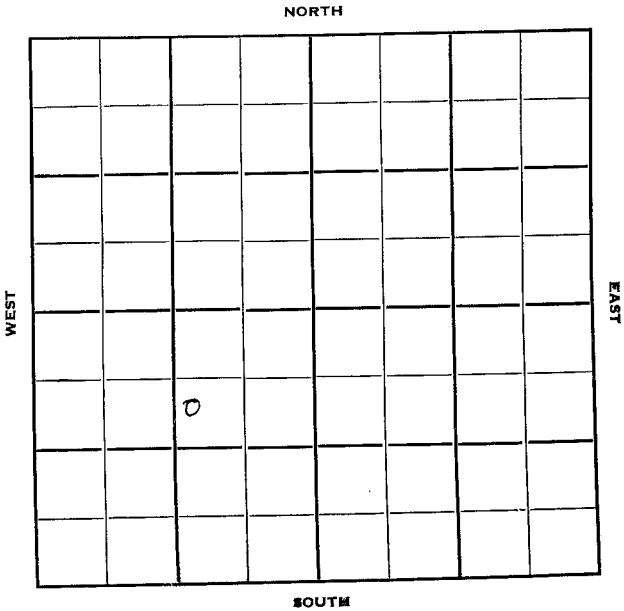

KANSAS

Seward

Sec. 27 Twp. 33 R. 34-W ✓

Well No. #1-27 Mix Farm

Panhandle Eastern Company

Contractor

Hugoton


Ft. from N. Line

1800 Ft. from S. Line

Ft. from E. Line

1370 Ft. from W. Line

SW NE SW

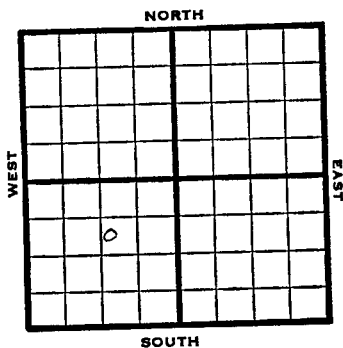

1950 Elev 2928 REPORT

8/2 Spud 7-26-50
10" @ 685

8/16 drlg 2330
10" @ 685
7" @ 2632

TD 2785

Hol 2578

Krider 2660

17000 total acid

Comp 16,291,000 gas

Completed

COMPLETED

Her 2630

Win 2742

Kansas

Hugoton Pool

Map No. _____ Sec. 27 Twp. 33 R. 34WWell No. 1-27 Nix_____ Panhandle Eastern _____ Company

_____ Contractor

SW NE SW

SECTION PLAT



_____ Ft. from N. Line

1800 Ft. from S. Line

_____ Ft. from E. Line

1370 Ft. from W. Line

Seward County

Location _____

Rig up _____

Drilling and Remarks:

Spud 7-26-50

10" @ 685

drlg. 2330

RECORD

Cased _____ in., _____ ft.

Sand _____

Gas _____

Oil _____

Total Depth _____

PRODUCTION

1st 24 hrs. Nat. _____

1st 24 hrs. after shot _____


Gas _____ Cu. Ft.

Dry Hole _____

Abandoned _____

Date

AUG 2 1950 19J. E. TYRA Scout

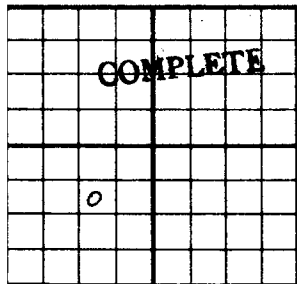County Seward State KansasSec. 27 (Blk. Twp.) 33 (Sur. Rge.) 34W Map No.Operator Panhandle EasternWell No. 1-27 Farm NixElev. 2928 Location SW NE SW1800 Ft. From S Line SW1370 Ft. From W Line Quarter1st. ReportCompletion AUG 16 1950RemarksSpudding Date 7-26-50Drig. Data Gas well TD 278510" @ 685 7" @ 2632 TD 2785Hol. 2578 Her. 2630 Krider 2660Win. 2742 17000 total acidComp. 16,291,000 gas

J. E. TYRA