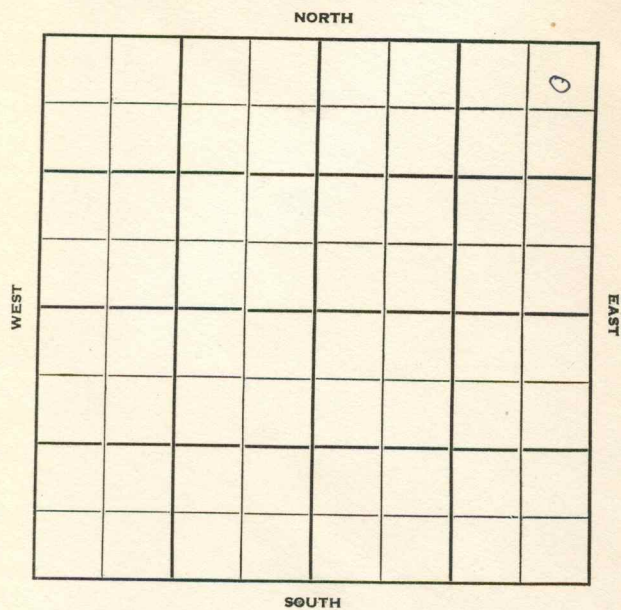


Section 15 Township 33 Range 28WWell No. #1 FriesenCompany Northern OrdnanceMeade KANSAS
Sec. 15 Twp. 33 R. 28WWell No. #1 Friesen FarmNorthern Ordnance Company

Contractor


330' Ft. from N. Line

Ft. from S. Line

330' Ft. from E. Line

Ft. from W. Line

NE NE NE

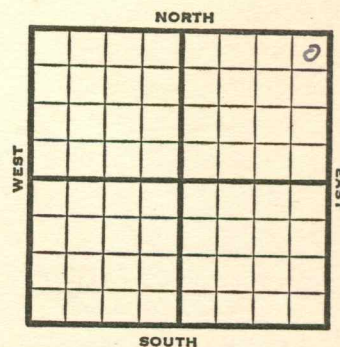

1951

REPORT

9/19 Location Deep Test

9/19 Abandoned Location

ABANDONED

J. E. TYRA

Date SEP 19 1951 19 J. E. TVDA Scout