


Section 28 Township 33 Range 43W

Well No. #1 Williams

Company Colorado O & G

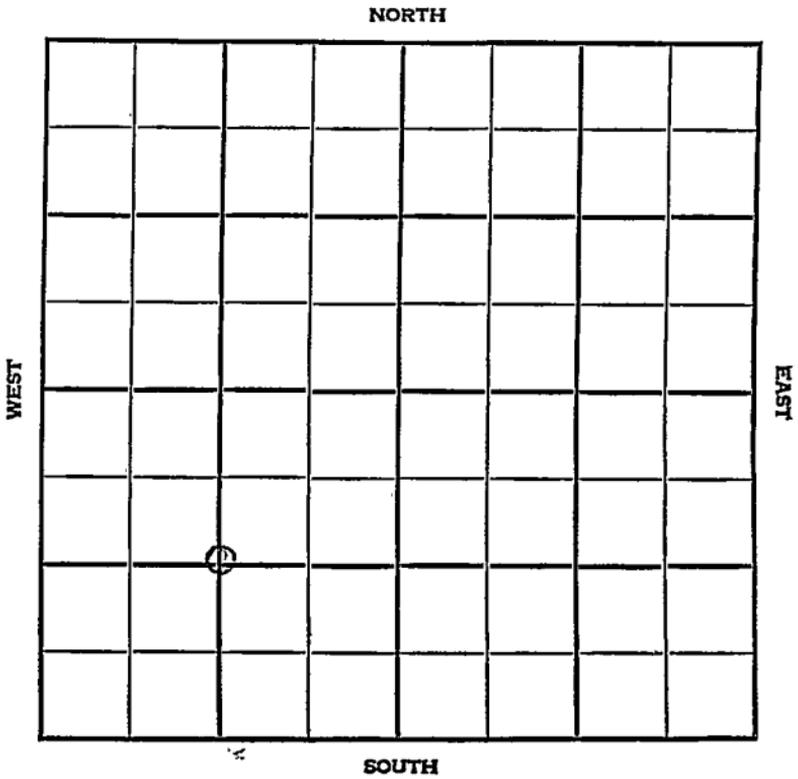

SEC.	TWP.	R.
28	33	43 W

WELL NO.

1 Williams

FARM

COMPANY

Colorado O & G

CONTRACTOR

Honaker


Greenwood

_____ Ft. from N. Line

_____ Ft. from S. Line

_____ Ft. from E. Line

_____ Ft. from W. Line

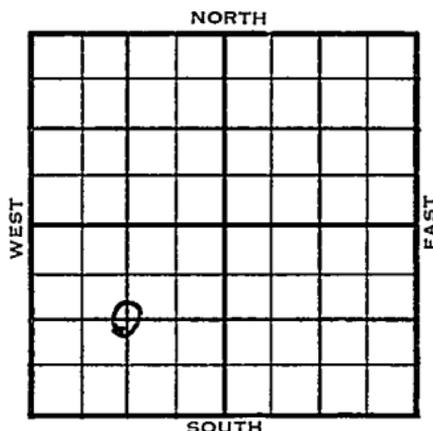

C SW/4

	ELEVATION	REPORT
1955	3645 DF	
6/8	Comm. 6-3-55 8" @ 626 /400 Drlg. 1625'	
8/3	DST 2060-74 op 2 hrs rec 20' sgcm, FP 0-50# BHP 3901#; 5 1/2" 3213; w/225 sx; CO 3176; perf 3164/69; 1000A sw no gas; Perf 3106-10 and 3102-04, 2000A sw no gas CO 3086; perf 3054-59; perf 3036 -45; perf 3029-33; perf 3022/25; 4500A swb 150 gwph gas test 134,000 cfg; tes t 355,000 cfg plus 35 gwph; plug 3014; perf 2995-3002; perf 2979-86, 2973-77 2959-64, 2939-44 5000A 3,434,000 cfg plud 80 gwph; plug 2925, 16/2904-08 40/2889-99; 2500 A; 3,444,000 cfg plus 120 gwph; plug to bott. plug 2880; 20/2850-55; 12/2814-17; 1500 A; test 2,400,000 cfg plus 45 gwph; PB 3176; t test 3,500,000 cfg; CO TD 3084; 5,053 000, cfg SIP 408# PB 3804 Anh. Wab 2689 Tp. Elm 2903 H. Tp 3029 Tr. Le Comp. 3159 TD 3220	

COMPLETED

County Morton ✓ Elev. _____
 Sec. 28 Twp. 33 Rge. 43W
 Company Colorado O & G
 Farm Name Williams No. 1

TOPS	DEPTH	LOG	DATUM
Anh.			
Tr.			
H.			
Tr.			
Dg.			
Bl.			
L.			
K.C.			
B.K.C.			
Ce.			
C.			
M.			
M.			
K.			
Mz.			
Ma.			
V.			
S.			
S.			
A.			
R.			
Pe.			
G.			
T.D.			

Loc. in Sec. G SW/4
 Geol. _____
 Contr. Honaker
 Pool Greenwood
 FIRST REPORT
 JUN 8 1955

Date Comm. 6-3-55
8" @ 626/400 drlg. 1625

K-131 ✓

Co.

Lse.

No.


Sec.

T.

R.

County Maton Elev. 3645 DF
 Sec. 28 Twp. 33S Rge. 43W
 Company Colorado Oil & Gas
 FarmName Williams No. 1

TOPS	DEPTH	LOG	DATUM
Anb. <u>Wab</u>		<u>2689</u>	
Tr. <u>Elm</u>		<u>2903</u>	
H. <u>TP</u>		<u>3029</u>	
Tr. <u>LeCamp</u>		<u>3159</u>	
Dg.			
Bl.			
L.			
K.C.			
B.K.C.			
Ce.			
C.			
M.			
M.			
K.			
Mz.			
Ma.			
V.			
S.			
S.			
A.			
R.			
PE.			
G.			
TD.	<u>3220</u>		

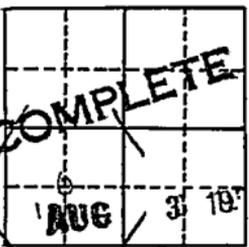Loc. in Sec. C SW/4
 Geol. _____
 Contr. _____
Honaker
 Pool _____
Greenwood

 No. 5

Date Comm. 6-3-55; 8" 3225; DST 3060-74 op
2 hrs. rec. 20' sgcm, FP 0-50#, BHP 3901#;
5 1/2" 3213; w/225 sx; CO 3176; perf/3164-69;
1000 A; sw no gas; perf/3106-10 and 3102-04
2000 A; sw no gas; CO 3086; perf/3054-59;
perf/3036-45; perf/3029-33; perf/3022-25;
4500 A; swb 150 gwph gas test 134,000 cfg;
test 355,000 cfg plus 35 gwph; plug 3014;
perf/2995-3002; perf/2979-86, 2973-77,
2959-64, 2939-44; 5000 A; 3,434,000 cfg plus

Co.
 Loc.
 No. 5
 Sec.
 T.
 R.

80 gwph; plug-2925; 16/2904-08; 40/2889-99;
2500 A; 3,444,000 cfg plus 120 gwph; plug to
bott; plug. 2880; 20/2850-55; 12/2814-17; -
1500 A; test 2,400,000 cfg plus 45 gwph;
PB 3176; test 3,500,000 cfg ; GO TD 3084;
5,053,000 cfg SIP 408#
PB 3804

.....	Misc
.....	Phone M-d
.....	France M-d
.....	Tracings
.....	Land Wall ()
.....	Lat. Small Mail
.....	Scout Cards

[Handwritten signature]

MAIL TO