


DX 78-1

Section 28 Township 33 Range 36th

Well No. 1 Carpenter "A"

Company Northern Pump

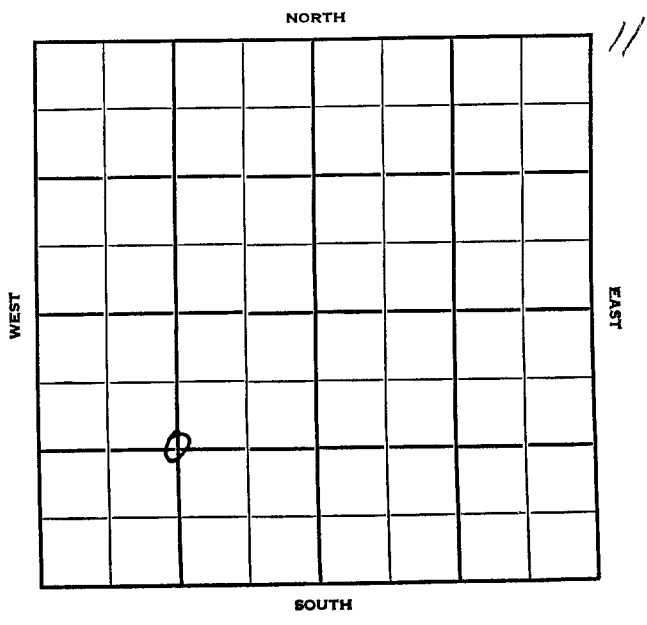

Stevens Kansas


SEC.	TWP.	R.
28	33	36W

WELL NO. _____
 COMPANY 1 Carpenter "A" FARM

CONTRACTOR Northern Pump

Hugoton Pool

_____ Ft. from N. Line
 1320 _____ Ft. from S. Line
 _____ Ft. from E. Line
 1320 _____ Ft. from W. Line

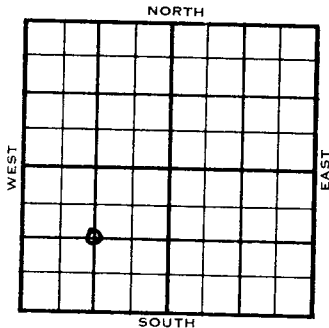

C SW/4

1954	ELEVATION 3062'	REPORT
------	-----------------	--------

7/14

Location

7/21

10" @ 235

8/25

Spud 7-14-54 Gas well TD 2805
 10" @ 235 7" @ 2776 TD 2795
 DD 2805 frac 310,000 CFG 5000 A
 7 MCFG 45,000 A 24/2690-96
 16/2698-2702 80/2654-74 3000 A
 Per. 2654 Pri. 2688 Win. 2710
 Ft. Riley 2772
 Comp. 17,800,000CFGPD 310#

COMPLETED

